

MISSISSIPPI DEPARTMENT OF NATURAL RESOURCES
Bureau of Land and Water Resources
 Southport Mall
 P.O. Box 10631
 Jackson, Mississippi 39209
WATER WELL DRILLERS LOG

Lowndes
G 2125

March 23 1987 Mid South Drilling Company Lowndes
 date well completed firm name county well located


LANDOWNER: Buford Electric Hwy 82 East Columbus, MS 39701	description of formations encountered	from	to	
Contractor: O. C. Electric 2002 4th Ave. N. Columbus (mailing address)				clay
WELL LOCATION: sec. <u>23</u> T. <u>18</u> XX S. R. <u>18</u> XX W. Hwy <u>69S</u> miles in <u>Columbus</u> (distance) (direction) (nearest town)	sand & gravel	3	16	
	clay	16	26	
	sand	26	29	
	clay	29	33	
	sand	33	37	
	clay	37	41	
	sand with clay streaks	41	64	
	clay	64	146	
	sand	146	150	
	clay	150	170	
WELL PURPOSE: store well (home, irrigation, municipal, industrial)	sand with clay streaks	170	184	
	sand	184	193	
	clay	193	206	
	sand with clay streaks	206	220	
	sand	220	243	
	sand with clay streaks	243	260	
	clay	260	270	
	WELL COMPLETION DATA:			
	(1) diameter (inches) <u>4</u>			
	(2) total depth (feet) <u>270</u>			
(3) static water level (feet) <u>25</u> below GROUND				
(4) casing <u>PVC</u> <u>160'</u> (material) (depth)				
<u>4"</u> (size) if telescope see back.				
(5) screen <u>none</u> (length) (depth to top)				
(size) (material)				
(6) pump <u>none</u> (HP) (yield gpm)				
(type power)				
(7) electric log <u>no</u> (yes or no)				
<u>none</u> (organization running log)				
(8) how well bottom plugged <u>open</u>				
DRILLERS REMARKS:				

REGISTERED
 MAR 26 1987

Department of Natural Resources
 Bureau of Land & Water

If well telescopes please
sketch and show depths.

GROUND LEVEL

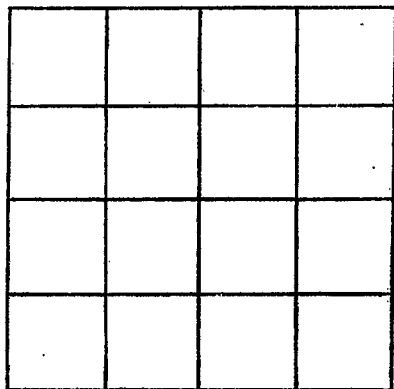

SECTION _____

Please indicate well location X.

ADDITIONAL INFORMATION

If more than one screen,
show locations of each on sketch.