

MISSISSIPPI DEPARTMENT OF NATURAL RESOURCES
Bureau of Land and Water Resources
 Southport Mall
 P.O. Box 10631
 Jackson, Mississippi 39209
WATER WELL DRILLERS LOG

LOWNDES
GT 2130

4-6-88 19 Mid South Drilling Company Lowndes
 date well completed firm name county well located

LANDOWNER: O. G. Electric
 (contractor)
 2002 4th ave.
 Columbus, MS 39701
 (mailing address)

WELL LOCATION:
 sec. 34 18
 T N R 18 E
 S W
2 miles south of Columbus
 (distance) (direction) (nearest town)

WELL PURPOSE: home
 (home, irrigation, municipal, industrial)

WELL COMPLETION DATA:

- (1) diameter (inches) ~~XXXX~~ 4"
- (2) total depth (feet) 167'
- (3) static water level (feet) 17 below top of ground. ~~XXXXXX~~
- (4) casing PVC, 157'
 (material) (depth)
4" if telescope see back.
 (size)
- (5) screen ~~XXX~~ 10', 157'
 (length) (depth to top)
.014, PVC
 (size) (material)
- (6) pump none
 (HP) (yield gpm)
 (type power)
- (7) electric log none
 (yes or no)
none
 (organization running log)
- (8) how well bottom plugged screened

description of formations encountered	from	to
	clay	0
sand	4	9
sand & gravel	9	15
clay	15	95
clay w/ sand streaks	95	100
sand	100	103
clay	103	110
clay w/ sand streaks	110	118
clay	118	148
sand w/ clay streaks	148	157
sand	157	167

rock at 70, 100, 103, 110, 118, 167

RECEIVED


APR 18 1988

Department of Natural Resources
 Bureau of Land & Water Resources

DRILLERS REMARKS:

If well telescopes please sketch and show depths.

GROUND LEVEL

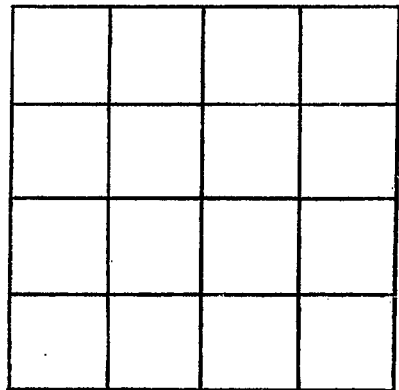

SECTION _____

Please indicate well location X.

ADDITIONAL INFORMATION

If more than one screen,
show locations of each on sketch.