

MISSISSIPPI DEPARTMENT OF NATURAL RESOURCES

Bureau of Land and Water Resources

COUNTY WELL LOCATED Grounds	
WELL NUMBER G 2131	CODED
DATE WELL COMPLETED 2/2/88	

PERMIT NUMBER
NAME OF DRILLING FIRM Clardy Wells Drill Columbus, Mo.

P.O. Box 10631
Jackson, Mississippi 39209
WATER WELL DRILLERS LOG

NAME & MAILING ADDRESS OF LANDOWNER Ralph Williamson P.O. Box 2268 Columbus, Mo.		
WELL LOCATION: SEC	TOWNSHIP	RANGE
6	18 N	18 E
DISTANCE	DIRECTION	NEAREST TOWN
1 1/4 Miles	West of	Columbus
OTHER LANDMARK		
WELL PURPOSE: Home, Irrigation, Municipal, Industrial, Fish Pond, etc. Industrial		

PUMP DATA		
PUMP TYPE (Circle One): <input checked="" type="radio"/> Submersible Turbine, Jet Flowing Well, Other (Describe) _____		
POWER TYPE (Circle One): <input checked="" type="radio"/> Electric Tractor, Diesel, Gasoline, Butane, Other (Describe) _____		
Pump Capacity (GPM) 2,250	No. of Stages 14	Setting Depth 76 FT.
PUMP TEST Well yielded 2,250 GPM with a drawdown of _____ ft. after _____ hours of pumping		

WELL DATA		
Well Depth 150'	Casing Diameter (In.) 4"	Casing Length (Ft.) 92'
Type of Casing PVC	Hole Depth	Depth to Static Water Level 20'
TYPE OF COMPLETION: (Circle One or More): Gravel Packed, Underreamed, Telescoped, Natural Development, Open Hole, Other (Describe) _____		
Top of Lap Pipe or Reduction in Casing FEET IF TELESCOPED OR MORE THAN ONE SCREEN: USE BACK PAGE		

LOG DATA			
TYPE OF LOG RUN (Circle One): No Log Run, Electric, Gamma Ray, Density, Sonic, Neutron, Other (Describe) _____			
Name of Organization Running Log DECEIVED GEOLOGIC DATA (Office Use Only)			
Surface Elev. FE 26	Geologic Unit 1009	Unit Thickness	Depth to Top
Subs. SWL	Date	Analysis	Aquifer Test


SCREEN DATA		
Diameter - Inches 2"	Length - Feet 40'	Slot Size - Inches .013
Screen Type PVC	Depth to Bottom - Feet	

Bureau of Land & Water Resources	
Bureau of Land & Water Resources	

DESCRIPTION OF FORMATIONS ENCOUNTERED	FROM	TO	FORMATIONS (Continued)	FROM	TO
Sandy clay	0	13	Sand streak	99	105
Sand & gravel	13	42	Rocky sandy streak	105	122
Sandy clay	42	83 1/2	Sand	122	132
Small rock	83 1/2		Sandy clay	132	135
Sandy clay	83 1/2	86	Sand	135	142
Fair clay	86	87	Sand streak	142	148
Sandy clay	87	93	Blue clay	148	150
Small rock	93				
Sandy clay	93	95			
Sand streak	95	96 1/2			
Sandy clay	96 1/2	99			

IF MORE SPACE IS NEEDED, USE BACK

If well telescopes please sketch and show depths.

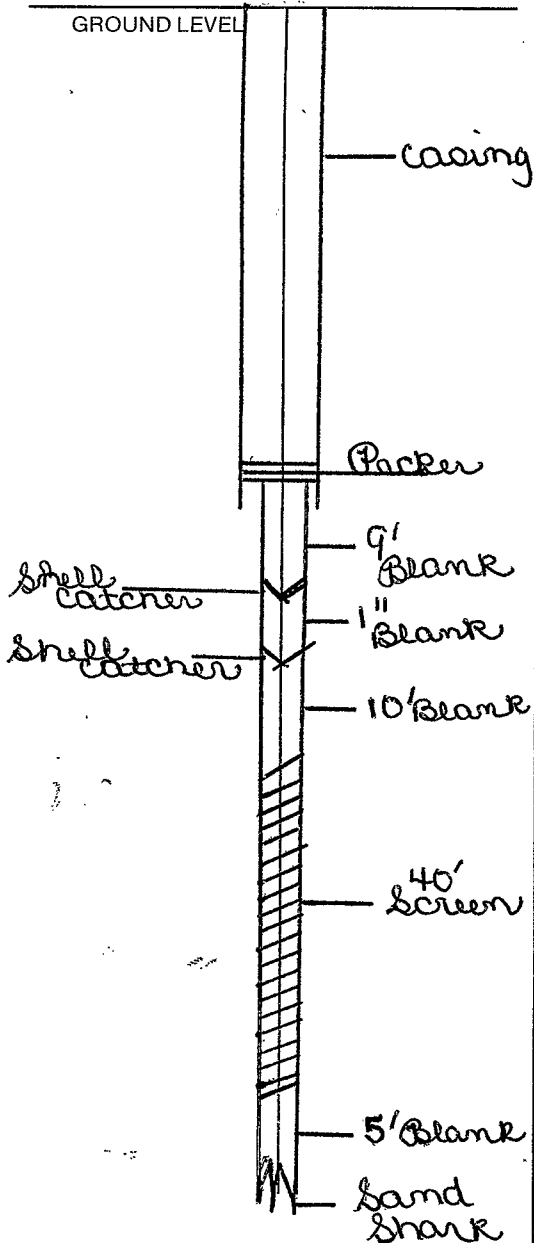

SECTION _____

Please indicate well location X.

ADDITIONAL INFORMATION

If more than one screen, show location of each on sketch.