

MISSISSIPPI DEPARTMENT OF NATURAL RESOURCES

Bureau of Land and Water Resources

P.O. Box 10631

Jackson, Mississippi 39209

WATER WELL DRILLERS LOG

COUNTY WELL LOCATED Round	
WELL NUMBER G 2132	CODED
DATE WELL COMPLETED 3/10/88	

PERMIT NUMBER
NAME OF DRILLING FIRM Clardy Well Drill Columbus, Mo

NAME & MAILING ADDRESS OF LANDOWNER Bob Taylor Plymouth Rd. Columbus, Mo 39101			
WELL LOCATION: SEC	TOWNSHIP	RANGE	
18	18 N	18 E	
DISTANCE	DIRECTION	NEAREST TOWN	
3/4	West	Columbus City	
OTHER LANDMARK			
WELL PURPOSE: Home, Irrigation, Municipal, Industrial, Fish Pond, etc. Home			

PUMP DATA		
PUMP TYPE (Circle One): Submersible , Turbine, Jet, Flowing Well, Other (Describe)		
POWER TYPE (Circle One): Electric , Tractor, Diesel, Gasoline, Butane, Other (Describe)		
Pump Capacity (GPM) 900	No. of Stages 10	Setting Depth 80 FT.
PUMP TEST		
Well yielded 900 GPM with a drawdown of _____ ft. after _____ hours of pumping		

WELL DATA		
Well Depth 210	Casing Diameter (In.) 4"	Casing Length (Ft.) 90'6"
Type of Casing PVC	Hole Depth	Depth to Static Water Level 24'
TYPE OF COMPLETION: (Circle One or More): Gravel Packed, Underreamed, Telescoped, Natural Development, Open Hole, Other (Describe)		
Top of Lap Pipe or Reduction in Casing FEET IF TELESCOPED OR MORE THAN ONE SCREEN: USE BACK PAGE		

LOG DATA	
TYPE OF LOG RUN (Circle One): No Log Run, Electric, Gamma Ray, Density, Sonic, Neutron, Other (Describe)	
Name of Organization Running Log RECEIVED	

GEOLOGIC DATA (Office Use Only)			
Surface Elev.	Geologic Unit APR 13	Unit Thickness 1988	Depth to Top
Subs. SWL	Date	Analysis	Aquifer Test

SCREEN DATA		
Diameter - Inches	Length - Feet	Slot Size - Inches
Screen Type	Depth to Bottom - Feet	


Department of Natural Resources Driller's Remarks Bureau of Land & Water Resources	

DESCRIPTION OF FORMATIONS ENCOUNTERED	FROM	TO	FORMATIONS (Continued)	FROM	TO
Red sandy clay	0	9	Blue clay	129 1/2	138
sand + gravel	9	28	sandy blue clay	138	152
sandy blue clay	28	77 1/2	sand w/ break	152	152 1/2
soft sandy clay	77 1/2	81	sandy clay	152 1/2	175 1/2
fine sandy blue clay	81	117	fine sand	175 1/2	185
small rock	117		sand	185	195
sandy clay	117	121	sandy clay	195	202
Blue clay	121	127 1/2	sm. rock	202	
sand w/ break	127 1/2	128	sand	202	203
clay	128	129	sandy blue clay	203	208
sand w/ break	129	129 1/2			

IF MORE SPACE IS NEEDED, USE BACK

If well telescopes please sketch and show depths.

GROUND LEVEL

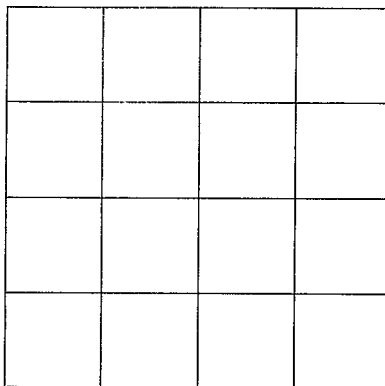

SECTION _____

Please indicate well location X.

ADDITIONAL INFORMATION

Small, vlock	208
Blue Clay	208-210
Rock	210

If more than one screen, show location of each on sketch.