

MISSISSIPPI DEPARTMENT OF NATURAL RESOURCES

Bureau of Land and Water Resources

P.O. Box 10631

Jackson, Mississippi 39209

WATER WELL DRILLERS LOG

| | |
|---------------------------------------|-------|
| COUNTY WELL LOCATED Bowling | |
| WELL NUMBER G 2135 | CODED |
| DATE WELL COMPLETED 7/8/88 | |

| |
|---|
| PERMIT NUMBER |
| NAME OF DRILLING FIRM Clardy Well Drill |
| Columbus Mo |

| | | |
|---|-------------|--------------------|
| NAME & MAILING ADDRESS OF LANDOWNER Arnold Weather | | |
| 300 Sylvan Rd. | | |
| Columbus, Mo 39702 | | |
| WELL LOCATION: SEC | TOWNSHIP | RANGE |
| 11 | 18 N | 18 E |
| DISTANCE | DIRECTION | NEAREST TOWN |
| Inside city | | of Columbus |
| OTHER LANDMARK | | |
| WELL PURPOSE: Home, Irrigation, Municipal, Industrial, Fish Pond, etc. Home | | |

| | | |
|---|---------------------------|--------------------------------|
| PUMP DATA | | |
| PUMP TYPE (Circle One): <input checked="" type="radio"/> Submersible, <input type="radio"/> Turbine, <input type="radio"/> Jet <input type="radio"/> Flowing Well, Other (Describe) _____ | | |
| POWER TYPE (Circle One): <input checked="" type="radio"/> Electric, <input type="radio"/> Tractor, <input type="radio"/> Diesel, <input type="radio"/> Gasoline, <input type="radio"/> Butane, Other (Describe) _____ | | |
| Pump Capacity (GPM) 900^H | No. of Stages 9 | Setting Depth 95 FT. |
| PUMP TEST Well yielded 900 GPM ^H with a drawdown of _____ ft. after _____ hours of pumping | | |

| | | |
|--|------------------------------------|----------------------------------|
| WELL DATA | | |
| Well Depth 170 | Casing Diameter (In.) 4" | Casing Length (Ft.) 98 |
| Type of Casing PVC | Hole Depth 15' | Depth to Static Water Level |
| TYPE OF COMPLETION: (Circle One or More): Gravel Packed, Underreamed, Telescoped, Natural Development, <input checked="" type="radio"/> Open Hole, Other _____ | | |
| Top of Lap Pipe or Reduction in Casing | | |
| FEET <input type="checkbox"/> IF TELESCOPED OR MORE THAN ONE SCREEN: USE BACK PAGE | | |

| | |
|--|--|
| LOG DATA | |
| TYPE OF LOG RUN (Circle One): <input type="radio"/> No Log Run, <input type="radio"/> Electric, <input type="radio"/> Gamma Ray, <input type="radio"/> Density, <input type="radio"/> Sonic, <input type="radio"/> Neutron, Other (Describe) _____ | |
| Name of Organization Running Log | |

| | | |
|-------------------|------------------------|--------------------|
| SCREEN DATA | | |
| Diameter - Inches | Length - Feet | Slot Size - Inches |
| Screen Type | Depth to Bottom - Feet | |


| | | | |
|---|---------------|----------------|--------------|
| GEOLOGIC DATA (Office Use Only) | | | |
| Surface Elev. | Geologic Unit | Unit Thickness | Depth to Top |
| Subs. SW | Date | Analysis | Aquifer Test |
| Driller's Remarks JUL 19 1988 | | | |
| Department of Natural Resources Bureau of Land & Water Resources | | | |

| DESCRIPTION OF FORMATIONS ENCOUNTERED | FROM | TO | FORMATIONS (Continued) | FROM | TO |
|---------------------------------------|--------|--------|------------------------|------|---------|
| Sand + gravel | 0 | 16 | Sandy clay | 91 | 94 |
| Clay | 16 | 22 | Clay | 94 | 97 |
| Sandy clay | 22 | 40 | Small rock | 97 | |
| Clay | 40 | 64 | Sandy clay | 97 | 100 |
| Sandy clay | 64 | 74 | Sand | 100 | 102 |
| Clay | 74 | 78 | Sandy clay | 102 | 104 1/2 |
| Sm. rock | 78 | | | | |
| Sandy clay | 78 | 78 1/2 | | | |
| Rock | 78 1/2 | 79 | | | |
| Clay | 79 | 91 | | | |
| Small rock | 91 | | | | |

IF MORE SPACE IS NEEDED, USE BACK

If well telescopes please
sketch and show depths.

GROUND LEVEL

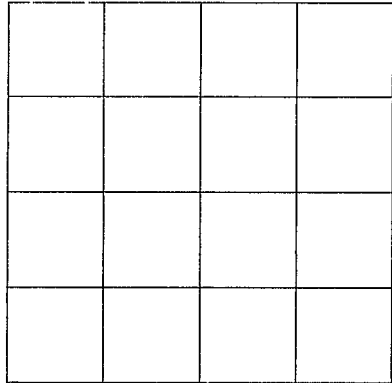

SECTION _____

Please indicate well location X.

ADDITIONAL INFORMATION

If more than one screen,
show location of each on sketch.