

MISSISSIPPI DEPARTMENT OF NATURAL RESOURCES
Bureau of Land and Water Resources

RECEIVED
FEB 08 1991

P.O. Box 70631
Jackson, Mississippi 39209

COUNTY WELL LOCATED
Lowndes

WELL NUMBER
G 2144

DATE WELL COMPLETED
2-1-91

PERMIT NUMBER
0-379

NAME OF DRILLING FIRM
Mid South Drilling Co.

Carrollton, AL 35447

NAME & MAILING ADDRESS OF LANDOWNER
Katie S. Frisbee

907 Tuscaloosa Road

Columbus, MS 39702

WELL LOCATION: SEC TOWNSHIP RANGE
12 18 S 18 W

DISTANCE DIRECTION NEAREST TOWN
Miles of

OTHER LANDMARK
Hwy 50 east in Columbus

WELL PURPOSE: Home, Irrigation, Municipal, Industrial, Fish Pond, etc.
home

PUMP DATA

PUMP TYPE (Circle One):
Submersible, Turbine, Jet, Flowing Well,
Other (Describe)

POWER TYPE (Circle One):
Electric, Tractor, Diesel, Gasoline, Butane,
Other (Describe)

Pump Capacity (GPM)	No. of Stages	Setting Depth
12	10	60 FT.

PUMP TEST

Well yielded **12** GPM with
a drawdown of **35** ft.
after **3** hours of pumping

WELL DATA

Well Depth 212'	Casing Diameter (In.) 4	Casing Length (Ft.) 96'
Type of Casing PVC	Hole Depth 212	Depth to Static Water Level 19'

TYPE OF COMPLETION: (Circle One or More):
Gravel Packed, Underreamed, Telescoped,
Natural Development, Open Hole, Other
(Describe)

Top of Lap Pipe or Reduction in Casing
FEET IF TELESCOPED OR MORE THAN ONE SCREEN: USE BACK PAGE

LOG DATA

TYPE OF LOG RUN (Circle One):
No Log Run, Electric, Gamma Ray, Density, Sonic, Neutron,
Other (Describe)

Name of Organization Running Log

SCREEN DATA

Diameter - Inches	Length - Feet	Slot Size - Inches
Screen Type	Depth to Bottom - Feet	

GEOLOGIC DATA (Office Use Only)

Surface Elev.	Geologic Unit	Unit Thickness	Depth to Top
Subs. SWL	Date	Analysis	Aquifer Test


Driller's Remarks

DESCRIPTION OF FORMATIONS ENCOUNTERED	FROM	TO	FORMATIONS (Continued)	FROM	TO
clay	0	8	sand	155	159
sand	8	12	clay w/sand streaks	159	180
gravel	12	22	sand w/clay streaks	180	194
sand	22	30	sand	194	212
sand & gravel	30	36			
sand - blue	36	44			
clay	44	99			
sand w/clay streaks	99	110			
clay w/ sand streaks	110	130			
sand	130	138			
clay w/ sand streak	138	155			

IF MORE SPACE IS NEEDED, USE BACK

If well telescopes please sketch and show depths.

GROUND LEVEL

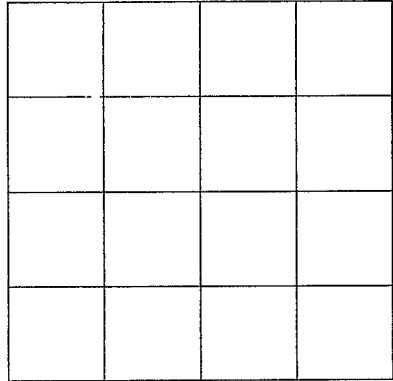

SECTION _____

Please indicate well location X.

ADDITIONAL INFORMATION

If more than one screen,
show location of each on sketch.