

MISSISSIPPI DEPARTMENT OF ENVIRONMENTAL QUALITY

Office of Land and Water Resources

P. O. Box 10631
Jackson, MS 39289-0631
WATER WELL DRILLERS LOG

COUNTY WELL LOCATED
Grounds

WELL NUMBER CODED
GT 2167

DATE WELL COMPLETED
3/4/94

PERMIT NUMBER

NAME OF DRILLING FIRM
**Clardy Well
Columbus, Ind.**

NAME & MAILING ADDRESS OF LANDOWNER
**Ralph Williams
P.O. Box 2268
Columbus, Ind 39104**

WELL LOCATION: SEC TOWNSHIP RANGE
23 18 N 18 E

DISTANCE DIRECTION NEAREST TOWN
Grades City of **Columbus**

OTHER LANDMARK

WELL PURPOSE: Home, Irrigation, Municipal, Industrial, Fish Pond, etc.
Industrial

PUMP DATA

PUMP TYPE (Circle One):
 Submersible, Turbine, Jet, Flowing Well,
Other (Describe) _____

POWER TYPE (Circle One):
 Electric, Tractor, Diesel, Gasoline, Butane,
Other (Describe) _____ H/P **1/2**

Pump Capacity (GPM) No. of Stages Setting Depth
35 9 90 FT.

PUMP TEST
Well yielded _____ GPM with
a drawdown of _____ ft.
after _____ hours of pumping

WELL DATA

Well Depth Casing Diameter (In.) Casing Length (Ft.)
202 4" 101'

Type of Casing Hole Depth Depth to Static Water Level
PVC

TYPE OF COMPLETION: (Circle One or More):
Gravel Packed, Underreamed, Telescoped,
Natural Development, Open Hole, Other
(Describe) _____

WELL GROUTED TO A DEPTH OF _____ FEET
Type Grout (circle one): Cement, Bentonite, or Mix

LOG DATA

TYPE OF LOG RUN (Circle One): No Log Run,
Electric, Gamma Ray, Density, Sonic, Neutron,
Other (Describe) _____

Name of Organization Running Log

RECEIVED

GEOLOGIC DATA (Office Use Only)

Surface Elev.	Geologic Unit	Unit Thickness	Depth to Top
Subs. SWL	Date	Analysis	Aquifer Test
		NOV 30 1994	

SCREEN DATA

Diameter - Inches Length - Feet Slot Size - Inches
2" 60' .013

Screen Type Depth to Bottom - Feet
PVC

Driller's Remarks


**Dept. of Environmental Quality
Office of Land & Water Resources**

DESCRIPTION OF FORMATIONS ENCOUNTERED	FROM	TO	FORMATIONS (Continued)	FROM	TO
Sand & gravel	0	24	Fine sand	145 1/2	148
Blue clay	24	62	Clay	148	158
Sandy clay	62	71	Rocky sand streak	158	162
Clay	71	97 1/2	Clay	162	172
Sandy clay	97 1/2	105 1/2	Sand streak	172	172 1/2
Rocky	105 1/2	106 1/2	Clay	172 1/2	178
Sandy clay	106 1/2	111	Sand streak	178	178 1/2
Rocky sand streak	111	122	Clay	178 1/2	180
Clay	122	136	Sand streak	180	181
Rocky sandy clay	136	143	Clay	181	182
Rocky sand streak	143	145 1/2	sand	182	193

IF MORE SPACE IS NEEDED, USE BACK

If well telescopes please sketch and show depths.

GROUND LEVEL

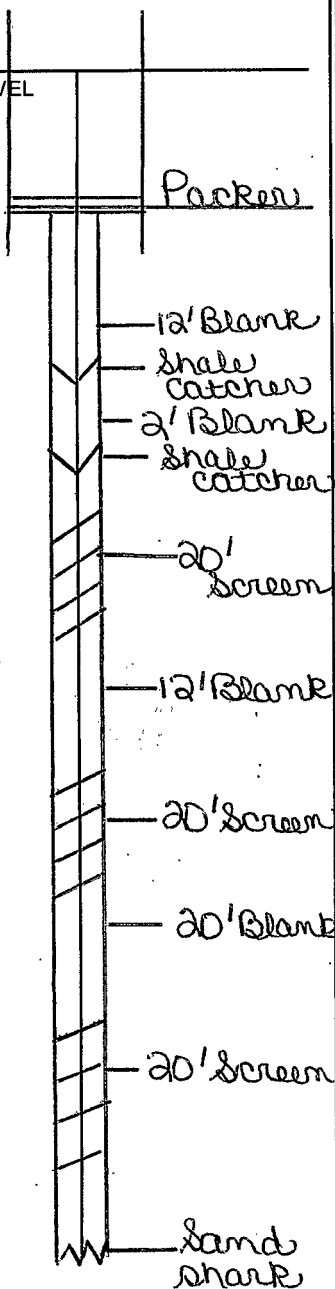

SECTION _____

Please indicate well location X.

ADDITIONAL INFORMATION

Rocky sand, st. 193-200
Sandy Clay 200-202

If more than one screen, show location of each on sketch.