

MISSISSIPPI DEPARTMENT OF ENVIRONMENTAL QUALITY
Bureau of Land and Water Resources

P. O. Box 10631
Jackson, MS 39289-0631
WATER WELL DRILLERS LOG

COUNTY WELL LOCATED	
Lowndes	
WELL NUMBER	CODED
1995	
DATE WELL COMPLETED	
9-15-94	

PERMIT NUMBER
0-379
NAME OF DRILLING FIRM
Mid South Drilling Co
Carrollton, AL 35447

NAME & MAILING ADDRESS OF LANDOWNER			
Billy James			
Coldwell Bank Realty			
P. O. Box 1002			
Columbus, MS 39703			
WELL LOCATION:	SEC	TOWNSHIP	RANGE
	26SW	18S	18 E
DISTANCE	DIRECTION	NEAREST TOWN	
1 Miles	S	of Columbus	
OTHER LANDMARK			
WELL PURPOSE: Home, Irrigation, Municipal, Industrial, Fish Pond, etc.			
home			

PUMP DATA		
PUMP TYPE (Circle One):		
<u>Submersible</u> , Turbine, Jet, Flowing Well,		
Other (Describe)		
POWER TYPE (Circle One):		
<u>Electric</u> , Tractor, Diesel, Gasoline, Butane,		
Other (Describe) H/P		
Pump Capacity (GPM)	No. of Stages	Setting Depth
10	10	60 FT.
PUMP TEST		
Well yielded 10 GPM with		
a drawdown of 13 ft.		
after 3 hours of pumping		

WELL DATA		
Well Depth	Casing Diameter (In.)	Casing Length (Ft.)
182	4	106
Type of Casing	Hole Depth	Depth to Static Water Level
PVC	182	22
TYPE OF COMPLETION: (Circle One or More):		
Gravel Packed, Underreamed, Telescoped,		
Natural Development, <u>Open Hole</u> , Other		
(Describe)		
Top of Lap Pipe or Reduction in Casing		
FEET IF TELESCOPED OR MORE THAN ONE SCREEN: USE BACK PAGE		

LOG DATA	
TYPE OF LOG RUN (Circle One):	
<u>No Log Run</u>	
Electric, Gamma Ray, Density, Sonic, Neutron,	
Other (Describe)	
Name of Organization Running Log	


SCREEN DATA		
Diameter - Inches	Length - Feet	Slot Size - Inches
Screen Type	Depth to Bottom - Feet	

GEOLOGIC DATA (Office Use Only)			
Surface Elev.	Geologic Unit	Unit Thickness	Depth To Top
Subs. SWL	Date	Analysis	Acquifer Test
Driller's Remarks			
SEP 23 1994			
Dept. of Environmental Quality Office of Land & Water Resources			

DESCRIPTION OF FORMATIONS ENCOUNTERED	FROM	TO	FORMATIONS (Continued)	FROM	TO
clay	000	006	sand	117	120
sand	006	013	clay	120	150
sand & gravel	013	022	sand	150	167
gravel	022	040	sand w/clay streaks	167	176
clay	040	070	sand	176	181
sand	070	088	clay	181	182
sand w/clay streaks	088	092			
sand	092	096			
clay	096	117			
IF MORE SPACE IS NEEDED, USE BACK					

If well telescopes please
sketch and show depths.

GROUND LEVEL

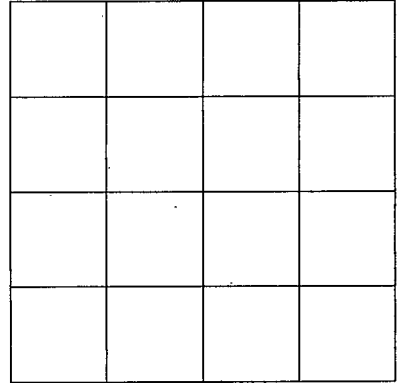

SECTION _____

Please indicate well location X.

ADDITIONAL INFORMATION

If more than one screen,
show location of each on sketch.