

MISSISSIPPI DEPARTMENT OF ENVIRONMENTAL QUALITY

Office of Land and Water Resources

P. O. Box 10631
Jackson, MS 39289-0631

WATER WELL DRILLERS LOG

COUNTY WELL LOCATED Downs	
WELL NUMBER CT 2176	CODED
DATE WELL COMPLETED 3/15/95	

PERMIT NUMBER
NAME OF DRILLING FIRM Clardy Well Columbus, Ind.

NAME & MAILING ADDRESS OF LANDOWNER McCary - West P.O. Box 2402 Columbus, Ind.			
WELL LOCATION:	SEC	TOWNSHIP	RANGE
	18	18^N	19^E
DISTANCE	DIRECTION	NEAREST TOWN	
50 yds	East	Columbus	
OTHER LANDMARK			
WELL PURPOSE: Home, Irrigation, Municipal, Industrial, Fish Pond, etc. Industrial			

PUMP DATA			
PUMP TYPE (Circle One): Submersible Turbine, Jet, Flowing Well, Other (Describe) _____			
POWER TYPE (Circle One): Electric Tractor, Diesel, Gasoline, Butane, Other (Describe) _____ H/P 1/2			
Pump Capacity (GPM)	No. of Stages	Setting Depth	
900	9	70 FT.	
PUMP TEST			
Well yielded _____ GPM with a drawdown of _____ ft. after _____ hours of pumping			

WELL DATA		
Well Depth 131	Casing Diameter (In.) 4"	Casing Length (Ft.) 71"
Type of Casing PVC	Hole Depth	Depth to Static Water Level 24'


TYPE OF COMPLETION: (Circle One or More):
Gravel Packed, Underreamed, Telescoped,
Natural Development, Open Hole, Other
(Describe) _____

WELL GROUTED TO A DEPTH OF _____ FEET
Type Grout (circle one): Cement, Bentonite, or Mix

SCREEN DATA		
Diameter - Inches	Length - Feet	Slot Size - Inches
Screen Type	Depth to Bottom - Feet	

LOG DATA	
TYPE OF LOG RUN (Circle One): No Log Run, Electric, Gamma Ray, Density, Sonic, Neutron, Other (Describe) _____	
Name of Organization Running Log	

GEOLOGIC DATA (Office Use Only)			
Surface Elev.	Geologic Unit	Unit Thickness	Depth to Top
Subs. SWL	Diaphragm Analysis	Acidifier Test	
Driller's Remarks			
APR 03 1995			
Top of Lap Pipe or Reduction in Casing			

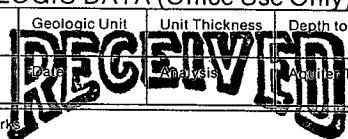


DESCRIPTION OF FORMATIONS ENCOUNTERED	FROM	TO	FORMATIONS (Continued)	FROM	TO
Brown sandycl.	0	12	Clay	115	117
sand & gravel	12	29	sand streak	117	121
sandy blue clay	29	47	sandy clay	121	122
Clay	47	93 1/2	sand	122	123 1/2
Rocky	93 1/2	94	fine sand	123 1/2	129
Clay	94	99	Clay	129	131
Rocky sand	99	101			
sandy clay	101	106			
Rocky	106	107			
Clay	107	111			
Rocky	111	115			

IF MORE SPACE IS NEEDED, USE BACK

Dept. of Environmental Quality
Office of Land & Water Resources

If well telescopes please
sketch and show depths.

GROUND LEVEL

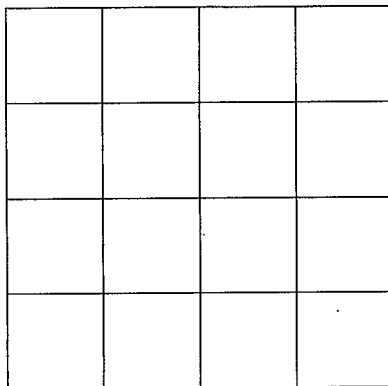

SECTION _____

Please indicate well location X.

ADDITIONAL INFORMATION

If more than one screen,
show location of each on sketch.