

MISSISSIPPI DEPARTMENT OF ENVIRONMENTAL QUALITY

Office of Land and Water Resources

P. O. Box 10631

Jackson, MS 39289-0631

WATER WELL DRILLERS LOG

COUNTY WELL LOCATED Lowndes	
WELL NUMBER 2714	CODED
DATE WELL COMPLETED 02-26-97	

PERMIT NUMBER 0-379
NAME OF DRILLING FIRM Mid&South Drilling Co.
Carrollton, AL 35447

NAME & MAILING ADDRESS OF LANDOWNER Steve Hines/ Rubens Fish House c/o Joe Johnson 406 Lemgerg Rd.	
Columbus, MS 39702	
WELL LOCATION: SEC 17 TOWNSHIP 18 RANGE N 18 E	
DISTANCE _____ MILES _____ OF _____	DIRECTION S NEAREST TOWN W
OTHER LANDMARK in Columbus near Hwy 82&182	
WELL PURPOSE: Home, Irrigation, Municipal, Industrial, Fish Pond, etc. Restuarant	

PUMP DATA		
PUMP TYPE (Circle One): <u>Submersible</u> , Turbine, Jet, Flowing Well, Other (Describe) _____		
POWER TYPE (Circle One): <u>Electric</u> , Tractor, Diesel, Gasoline, Butane, Other (Describe) _____ H/P _____		
Pump Capacity (GPM) 15	No. of Stages 14	Setting Depth 140 FT.
PUMP TEST Well yielded 15 GPM with a drawdown of 40 ft. after 3 hours of pumping		

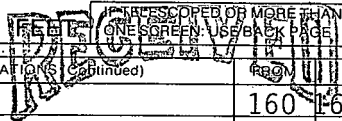
WELL DATA		
Well Depth 210	Casing Diameter (In.) 4	Casing Length (Ft.) 200
Type of Casing PVC	Hole Depth 210	Depth to Static Water Level 25
TYPE OF COMPLETION: (Circle One or More): <u>Gravel Packed</u> , Underreamed, Telescoped, Natural Development, Open Hole, Other		
WELL GROUTED TO A DEPTH OF _____ FEET Type Grout (circle one): Cement, Bentonite, or Mix		

LOG DATA	
TYPE OF LOG RUN (Circle One): Electric, Gamma Ray, Density, Sonic, Neutron, Other (Describe) _____	
<u>No Log Run</u>	
Name of Organization Running Log	

SCREEN DATA		
Diameter - Inches 4	Length - Feet 10	Slot Size - Inches .032
Screen Type PVC	Depth to Bottom - Feet 210	

GEOLOGIC DATA (Office Use Only)			
Surface Elev.	Geologic Unit	Unit Thickness	Depth to Top
Subs. SWL	Date	Analysis	Aquifer Test
Driller's Remarks			
Top of Lap Pipe or Reduction in Casing			

DESCRIPTION OF FORMATIONS ENCOUNTERED	FROM	TO	FORMATION (S) (Continued)	FROM	TO
topsoil	000	006	clay	160	164
clay	006	017	sand	164	176
sand & gravel	017	023	clay	176	196
clay	023	060	sand	196	210
clay & sand	060	080			
clay	080	092	rock at 92		
sand	092	094			
clay	094	106			
sand	106	110			
clay & sand	110	155			
sand	155	160			


MAR 21 1997
 Dept. of Environmental Quality
 Office of Land & Water Resources

IF MORE SPACE IS NEEDED, USE BACK

If well telescopes please sketch and show depths.

GROUND LEVEL

SECTION _____

Please indicate well location X.

ADDITIONAL INFORMATION

If more than one screen,
show location of each on sketch.