

**MISSISSIPPI DEPARTMENT OF ENVIRONMENTAL QUALITY**

Office of Land and Water Resources

P. O. Box 10631  
Jackson, MS 39289-0631  
**WATER WELL DRILLERS LOG**

COUNTY WELL LOCATED <b>Lowndes</b>	
WELL NUMBER <b>G-2206</b>	CODED
DATE WELL COMPLETED <b>6/13/01</b>	

PERMIT NUMBER <b>0-654</b>
NAME OF DRILLING FIRM <b>Mid-South Drilling Co, inc</b>

NAME & MAILING ADDRESS OF LANDOWNER <b>Bull Dog Ready-Mix O.C. Electric (contractor) P.O. Box 581, Columbus, MS 39703</b>		
WELL LOCATION: SEC	TOWNSHIP	RANGE
<b>10</b>	<b>18 N</b>	<b>18 E</b>
DISTANCE	DIRECTION	NEAREST TOWN
_____ Miles	_____ of	<b>Columbus</b>
OTHER LANDMARK		
WELL PURPOSE: Home, Irrigation, Municipal, Industrial, Fish Pond, etc. <b>Industrial</b>		

<b>PUMP DATA</b>		
PUMP TYPE (Circle One): <b>no pump</b> <del>Other</del> Turbine, Jet, Flowing Well, Other (Describe) _____		
POWER TYPE (Circle One): Electric, Tractor, Diesel, Gasoline, Butane, Other (Describe) _____ H/P _____		
Pump Capacity (GPM)	No. of Stages	Setting Depth  <b>_____ FT.</b>
<b>PUMP TEST</b>		
Well yielded _____ GPM with a drawdown of _____ ft. after _____ hours of pumping		

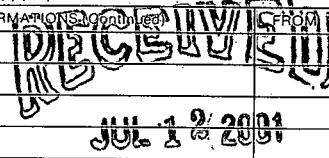
<b>WELL DATA</b>		
Well Depth <b>241'</b>	Casing Diameter (In.) <b>4"</b>	Casing Length (Ft.) <b>125'</b>
Type of Casing <b>PVC</b>	Hole Depth <b>241'</b>	Depth to Static Water Level <b>17'</b>
TYPE OF COMPLETION: (Circle One or More): Gravel Packed, Underreamed, Telescoped, Natural Development, <b>Open Hole</b> , Other (Describe) _____		

<b>LOG DATA</b>	
TYPE OF LOG RUN (Circle One): <b>No Log Run</b> Electric, Gamma Ray, Density, Sonic, Neutron, Other (Describe) _____	
Name of Organization Running Log	

WELL GROUTED TO A DEPTH OF _____ FEET
Type Grout (circle one): Cement, Bentonite, or Mix

<b>GEOLOGIC DATA (Office Use Only)</b>			
Surface Elev.	Geologic Unit	Unit Thickness	Depth to Top
Subs. SWL	Date	Analysis	Aquifer Test
Driller's Remarks			
Top of Lap Pipe or Reduction in Casing			
<b>FEET</b>		IF TELESCOPED OR MORE THAN ONE SCREEN: USE BACK PAGE	

<b>SCREEN DATA</b>		
Diameter - Inches	Length - Feet	Slot Size - Inches
Screen Type	Depth to Bottom - Feet	

DESCRIPTION OF FORMATIONS ENCOUNTERED	FROM	TO	FORMATIONS (Continued)	FROM	TO
clay	0	4			
sand	4	7			
gravel	7	11			
clay	11	165			
sand	165	190			
clay	190	207			
sand	207	241			

Dept. of Environmental Quality  
Office of Land & Water Resources

IF MORE SPACE IS NEEDED, USE BACK

If well telescopes please  
sketch and show depths.

GROUND LEVEL


SECTION \_\_\_\_\_

Please indicate well location X.

ADDITIONAL INFORMATION

If more than one screen,  
show location of each on sketch.