

MISSISSIPPI DEPARTMENT OF ENVIRONMENTAL QUALITY

Office of Land and Water Resources

P. O. Box 10631
Jackson, MS 39289-0631
WATER WELL DRILLERS LOG

COUNTY WELL LOCATED
Groundwater

WELL NUMBER G-2207 CODED

DATE WELL COMPLETED
3/14/02

PERMIT NUMBER

NAME OF DRILLING FIRM
Clardy Well Dr.
Columbus, MS

NAME & MAILING ADDRESS OF LANDOWNER
Wulbrin Colom
800 2nd St South
Columbus, MS 39102

Latitude:
Longitude:

WELL LOCATION. SEC 21 TOWNSHIP 18 N RANGE 18 E

DISTANCE _____ DIRECTION _____ NEAREST TOWN _____
Miles _____ of _____

OTHER LANDMARK
Inside City Limits

WELL PURPOSE: Home, Irrigation, Municipal, Industrial, Fish Pond, etc.
Irrigation

WELL DATA

Well Depth <u>376</u>	Casing Diameter (In.) <u>4"</u>	Casing Length (Ft.) <u>180</u>
Type of Casing <u>PVC</u>	Hole Depth <u>371</u>	Depth to Static Water Level <u>371</u>

TYPE OF COMPLETION: (Circle One or More):
Gravel Packed, Underrreamed, Telescoped,
Natural Development, Open Hole, Other
(Describe) _____

WELL GROUTED TO A DEPTH OF 20 FEET
Type Grout (circle one): Cement, Bentonite or Mix

SCREEN DATA

Diameter - Inches <u>2"</u>	Length - Feet <u>60'</u>	Slot Size - Inches <u>.013</u>
Screen Type <u>PVC</u>	Depth to Bottom - Feet	

PUMP DATA

PUMP TYPE (Circle One):
Submersible, Turbine, Jet, Flowing Well,
Other (Describe) _____

POWER TYPE (Circle One):
Electric, Tractor, Diesel, Gasoline, Butane,
Other (Describe) _____ H/P 5

DESCRIPTION OF FORMATIONS ENCOUNTERED	FROM	TO
<u>Red Clay</u>	<u>0</u>	<u>8</u>
<u>Grey sandy clay</u>	<u>8</u>	<u>18</u>
<u>sandy blue clay</u>	<u>18</u>	<u>130</u>
<u>Clay</u>	<u>130</u>	<u>172</u>
<u>sandy clay</u>	<u>172</u>	<u>177</u>
<u>Fair Sand</u>	<u>177</u>	<u>194</u>
<u>sand</u>	<u>194</u>	<u>198</u>
<u>sandy clay</u>	<u>198</u>	<u>222</u>
<u>Rocky sandy clay</u>	<u>222</u>	<u>240</u>
<u>Clay</u>	<u>240</u>	<u>250</u>
<u>sandy clay</u>	<u>250</u>	<u>270</u>
<u>Fine rocky clay</u>	<u>270</u>	<u>282</u>
<u>sandy clay</u>	<u>282</u>	<u>289</u>
<u>sand streak</u>	<u>289</u>	<u>294</u>
<u>sandy clay</u>	<u>294</u>	<u>342</u>
<u>Fine sandy clay</u>	<u>342</u>	<u>356</u>
<u>sand</u>	<u>356</u>	<u>364</u>
<u>white clay</u>	<u>364</u>	<u>376</u>

Top of Lap Pipe or Reduction in Casing

FEET IF TELESCOPED OR MORE THAN ONE SCREEN: USE BACK PAGE


I certify that the well was drilled, constructed and completed in accordance with all applicable Requirements of the Mississippi Department of Environmental Quality and of the Mississippi Department of Health regulations and state laws.

D. Thel 0-496
Signature of Licensed Driller and License No.

RECEIVED
MAR 22 2002
BY: 01/30/02
Date

Additional Information Required On Back

If well telescopes please sketch and show depths.

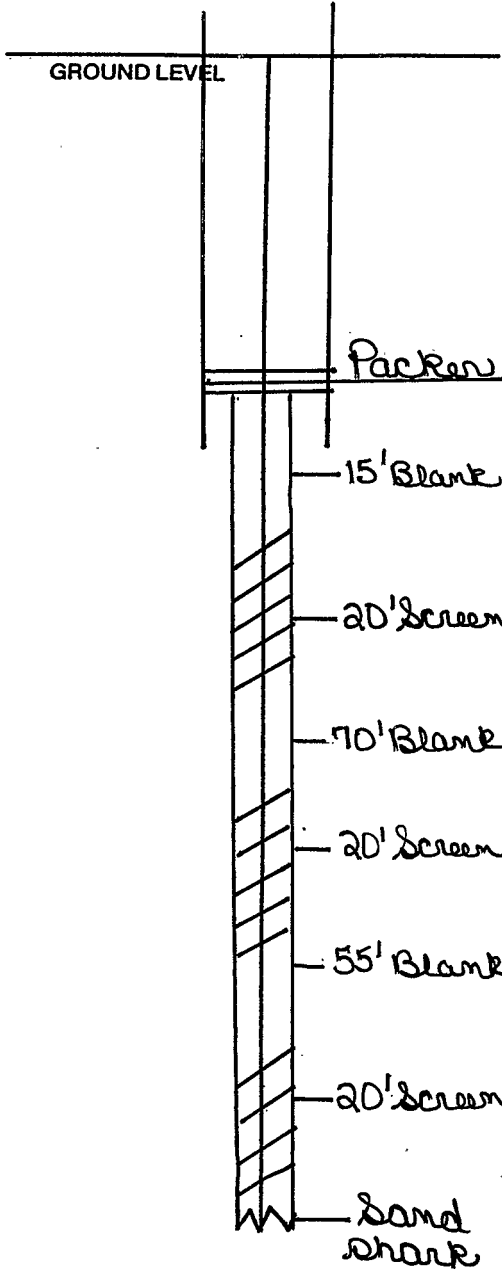

If more than one screen, show location of each on sketch.

SECTION _____

Please indicate well location X.

Pump Capacity (GPM)	No. of Stages	Setting Depth
60	15	147 FT.

PUMP TEST

Well yielded 60 GPM with a drawdown of _____ ft. after _____ hours of pumping

LOG DATA

TYPE OF LOG RUN (Circle One): No Log Run, Electric, Gamma Ray, Density, Sonic, Neutron, Other (Describe) _____

Name of Organization Running Log _____

GEOLOGIC DATA (Office Use Only)

Surface Elev.	Geologic Unit	Unit Thickness	Depth to Top
Subs. SWL	Date	Analysis	Aquifer Test

Driller's Remarks
