

BOARD OF WATER COMMISSIONERS
416 North State Street
Jackson, Mississippi 39201

WATER WELL DRILLERS LOG

Lowndes
H

August 14 1984 Mid South Drilling Company Lowndes
date well completed firm name county well located

LANDOWNER: John B. Hardy, Sr.
Rt. 1 Box 256
Columbus MS 39701
(mailing address)

WELL LOCATION:
sec. 3 T. 10 N. R. 17 E.
S. X. W. X.
8 miles south of Columbus
(distance) (direction) of (nearest town)

WELL PURPOSE: home
(home, irrigation, municipal, industrial)

- WELL COMPLETION DATA:
- (1) diameter (inches) 4"
 - (2) total depth (feet) 598'
 - (3) static water level (feet) 40 below top of ground. ~~268.72~~
 - (4) casing PVC 558'
(material) (depth)
4"
(size) if telescope see back.
 - (5) screen 40' 558'
(length) (depth to top)
4" 032 PVC
(size) (material)
 - (6) pump 1 1/2 15
(HP) (yield gpm)
electric
(type power)
 - (7) electric log no
(yes or no)
no
(organization running log)
 - (8) how well bottom plugged screen

description of formations encountered	from	to
clay	0	180
clay and sand	180	345
clay	345	390
clay and sand	390	430
clay	430	438
clay and sand	438	565
sand	565	598
rock at 450'; 456'; 463'		

DEPT. OF NATURAL RESOURCES
BUREAU OF LAND & WATER RESOURCES


OCT - 1 1984

RECEIVED

DRILLERS REMARKS:

If well telescopes please
sketch and show depths.

GROUND LEVEL

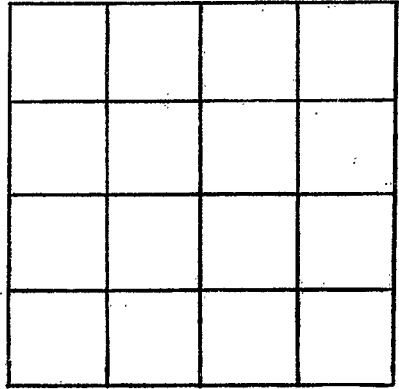

SECTION _____

Please indicate well location X.

ADDITIONAL INFORMATION

If more than one screen,
show locations of each on sketch.