

H

8-18-60

WATER WELL DRILLERS LOG

Date: 8-18, 19 60 Driller: W.J. REEVES County LOWMEYER
 (Name)

(1) Owner of Land: F.S. & F. (CONTR)
 (Name)
COLUMBUS MISS
 (Address)

(2) Location: 1/4, 1/4, Sec. T. R.
4 miles E, of COLUMBUS
 (distance) (direction) (Nearest Town)

(3) Topography: FLAT
 (Hilly) (Flat) (Level)

(4) Purpose of Well: DOMESTIC
 (Domestic Irrigation
 Municipal, Industrial, Other)

Description & Color of Materials
 Sand, Clay, Red Clay, Shell, etc.

Thick-
 ness
 Feet

Depth
 Feet

SAND & GRAVEL 41 0
BLUE CLAY 19 41
" SAND 30 60

Information upon completion of well:

(1) Diameter 4 inches.

(2) Total Depth 90 feet.

(3) Water Level 8 feet below top of ground.

(4) Cased to 44', Size 4"


(5) Screen: Size , Length

(6) Were any formations sealed against pollution?
 yes, no.

If YES depth of formation

Why

Drillers Remarks:

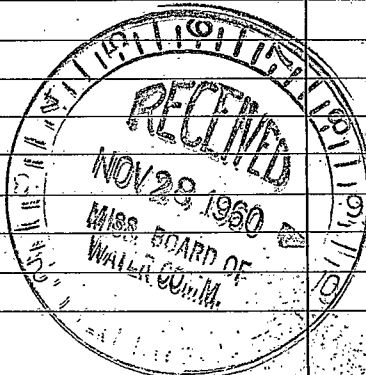

(Use Back Side)

Well No

