

Louder  
#  
7-66

MISSISSIPPI BOARD OF WATER COMMISSIONERS

10 9  
WATER WELL DRILLERS LOG

Date: July, 1966, Driller: W. B. Clardy County Louder  
(Name)

(1) Owner of Land: <u>McBryde &amp; Shelton</u> (Name)	Description & Color of Materials Sand, Clay, Red Clay, Shell, etc.	Thick- ness Feet	Depth Feet
<u>1120 Gardner Blvd.</u> Well in <u>Biggs Sub.</u> (Address)	<u>Sand + gravel</u>	<u>10'</u>	<u>27'</u>
(2) Location: <u>1/4, 1/4, Sec 5 T. R.</u> <u>3</u> miles <u>E</u> of <u>Coto</u> (distance) (direction) (Nearest Town)	<u>Blue Clay</u>	<u>27'</u>	
(3) Topography: <u>flat</u> (Hilly) (Flat) (Level)	<u>Sand</u>	<u>45' - 50'</u>	
(4) Purpose of Well: <u>Domestic</u> (Domestic Irrigation Municipal, Industrial, Other)	<u>Sand</u>	<u>75' - 92'</u>	
	<u>Sand</u>	<u>115' - 130'</u>	


Information upon completion of well:

- (1) Diameter 4 inches.
- (2) Total Depth 130 feet.
- (3) Water Level 7 feet below top of ground.
- (4) Cased to 35 1/2, Size 4"
- (5) Screen: Size \_\_\_\_\_, Length \_\_\_\_\_
- (6) Were any formations sealed against pollution?  
\_\_\_\_\_ yes, \_\_\_\_\_ no.

If YES depth of formation \_\_\_\_\_  
Why \_\_\_\_\_

Drillers Remarks: \_\_\_\_\_  
\_\_\_\_\_  
\_\_\_\_\_

streaks of blue clay between sand

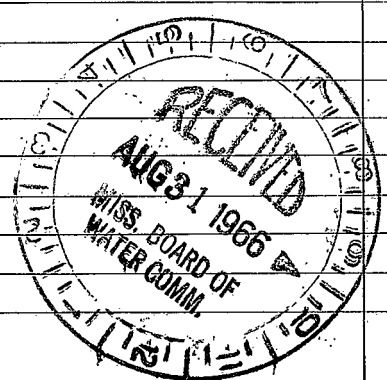

(Use Back Side)

Well No

