

WATER WELL DRILLERS LOG

Date: 1-9, 1961, Driller: W. J. REEVES & SON County LOWNDES

(Name)

(1) Owner of Land: FIELDS & SHESTON  
(Name)

COLUMBUS MISS.  
(Address)

(2) Location: 1/4, 1/4, Sec.     T.     R.    

1/2 miles E, of COLUMBUS,  
(distance) (direction) (Nearest Town)

(3) Topography: FLAT  
(Hilly) (Flat) (Level)

(4) Purpose of Well: DOMESTIC  
(Domestic Irrigation  
Municipal, Industrial, Other)

Information upon completion of well:

(1) Diameter 4 inches.

(2) Total Depth 90 feet.

(3) Water Level 6 feet below top of ground.

(4) Cased to 22 1/2, Size 4

(5) Screen: Size    , Length    .


(6) Were any formations sealed against pollution?  
    yes,     no.

If YES depth of formation    .

Why    

Drillers Remarks:    

Description & Color of Materials Sand, Clay, Red Clay, Shell, etc.	Thick- ness Feet	Depth Feet
<u>CLAY</u>	<u>8</u>	<u>0</u>
<u>SAND &amp; GRAVEL</u>	<u>11</u>	<u>8</u>
<u>BLADE CLAY</u>	<u>17</u>	<u>19</u>
<u>BLUE SAND - CLAY STRKS</u>	<u>57</u>	<u>36</u>

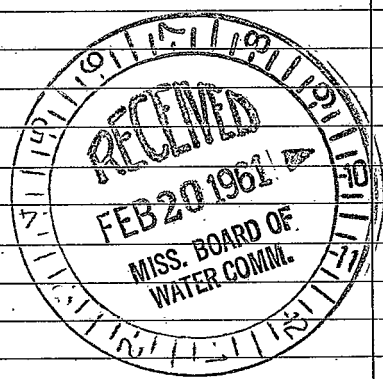

(Use Back Side)

Well No.

