

WATER WELL DRILLERS LOG

H
8-22-61

Date: 8-22, 1961, Driller: J C REEVES County LOWNDES

(Name)

(1) Owner of Land: F. S. & F. CONTRAS
(Name)
Columbus, Miss
(Address)

(2) Location: 1/4, 1/4, Sec. T R
1 miles E, of COLUMBUS
(distance) (direction) (Nearest Town)

(3) Topography: LEVEL
(Hilly) (Flat) (Level)

(4) Purpose of Well: DOM.
(Domestic Irrigation
Municipal, Industrial, Other)

Description & Color of Materials Sand, Clay, Red. Clay, Shell, etc.	Thick- ness Feet	Depth Feet
CLAY	13	0
SAND & GRAVEL	9	13
BLUE CLAY	23	22
1" SAND	9	45
" CLAY	12	54
" SAND	5	66
" CLAY	7	71
" SAND	12	78

Information upon completion of well:

(1) Diameter 4 inches.

(2) Total Depth 90 feet.

(3) Water Level 7 feet below top of ground.

(4) Cased to 25' 8", Size 4"


(5) Screen: Size , Length

(6) Were any formations sealed against pollution?
 yes, no.

If YES depth of formation

Why

Drillers Remarks:

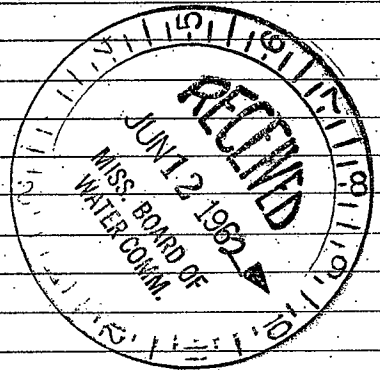

(Use Back Side)

Well No.

THE HISTORY OF THE

Faint, illegible text covering the majority of the page, appearing to be a historical document or manuscript.