

H

WATER WELL DRILLERS LOG

8-19-61

Date: 8-19, 1961, Driller: J.C. REEVES County LOWNDES

(Name)

(1) Owner of Land: McBrule Realty Co. Columbus, Miss

Description & Color of Materials Sand, Clay, Red Clay, Shell, etc.

Thickness Feet

Depth Feet

Table with 3 columns: Description & Color of Materials, Thickness Feet, Depth Feet. Rows include CLAY, SAND & GRAVEL, BLUE CLAY, SAND, CLAY, SAND.

(2) Location: 1/4, 1/4, Sec. T R, 1 miles E of Columbus

(3) Topography: LEVEL

(4) Purpose of Well: DOM. (Domestic Irrigation, Municipal, Industrial, Other)


Information upon completion of well:

- (1) Diameter 4 inches. (2) Total Depth 90 feet. (3) Water Level 7 feet below top of ground. (4) Cased to 31', Size 4". (5) Screen: Size, Length. (6) Were any formations sealed against pollution? yes, no.

If YES depth of formation

Why

Drillers Remarks:

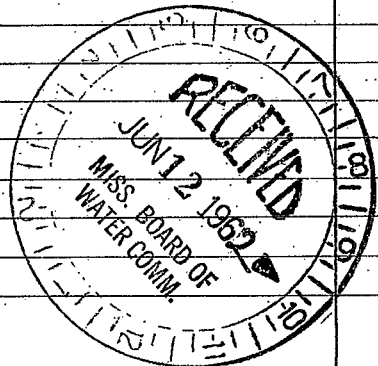

(Use Back Side)

Well No.

