

Well # 1

Soundes  
H14  
12-1-65  
M.G.S.  
12-1

MISSISSIPPI  
BOARD OF WATER COMMISSIONERS  
416 North State Street  
Jackson, Mississippi 39201

WATER WELL DRILLERS LOG

date well completed 1965 Herndon-Homan Well Survey Soundes  
firm name Inc. county well located

LANDOWNER: East Soundes	description of formations encountered	from	to
Water, Anna			
Columbus, Miss. (mailing address)	Red clay	0	8.6
	Sand + gravel (water)	8.6	28
	Blue clay, sand streak	28	102
	Silt sand	102	134
	Blue clay, streak sand	134	172
	Blue clay	172	195
	Silt + sand (little water)	195	216
	Blue clay, streak sand	216	324
	Sand (little water)	324	341
	white chalk (gummy)	341	365
	Sand (water)	365	384
	White chalk (very gummy)	384	392
	water sand	392	424
	Red clay (very gummy)	424	432
	gravel (white)	432	460
	Bottom	460	

WELL LOCATION:

sec. 14 T. 18 R. 17  
1400' N + 100' E of SW cor. of Sec.  
(distance) miles (direction) of (nearest town)

WELL PURPOSE: COMMUNITY  
(home, irrigation, municipal, industrial)

WELL COMPLETION DATA:

- (1) diameter (inches) 10"
- (2) total depth (feet) 460
- (3) static water level (feet) 105 below top of ground.
- (4) casing (material) Steel, (depth) 392', (size) 10" if telescope see back.
- (5) screen (length) 60', (depth to top) 400', (size) 6" 304 stainless steel (material)
- (6) pump 25 (HP), 350 (yield gpm), electric (type power)
- (7) electric log yes (yes or no), Min. Geological Survey (organization running log)
- (8) how well bottom plugged B/W

DRILLERS REMARKS:

APR 30 1965  
MISS. BD. OF WATER COMMISSIONERS  
MISS. BD. OF WATER COMMISSIONERS

(X)

If well telescopes please sketch and show depths.

H 14

GROUND LEVEL

392' of  
10" casing


GRAVEL  
WELL

6" casing

Depth  
to top  
of screen  
400'

60' of  
screen

If more than one screen,  
show locations of each on sketch.

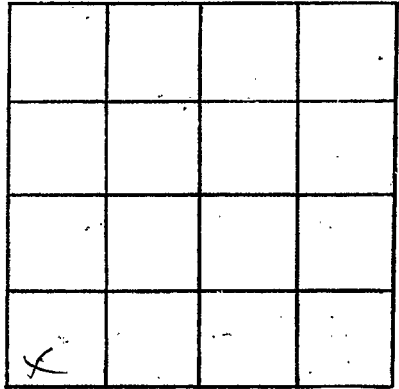

SECTION 17

Please indicate well location X.

ADDITIONAL INFORMATION

Multiple horizontal lines for additional information.