

CODED

CODED

CODED

MISSISSIPPI BOARD OF WATER COMMISSIONERS  
416 North State Street  
Jackson, Mississippi 39201

WATER WELL DRILLERS LOG

Lowndes.  
H 15  
8-68

Aug. 19 68 date well completed  
Clardy Well Drilling firm name  
Lowndes county well located

LANDOWNER: B. C. McCullough

description of formations encountered from to

Hwy. 82 E.  
Columbus, Miss.  
(mailing address)

Blue Clay 65' 120'  
streak of sand 120 135'  
Blue Clay 135 140'  
Coarse sand 140 160'

WELL LOCATION:  
sec. 30 T. 18 N. R. 10 E. S. 17  
SW (W)

(distance) miles (direction) of (nearest town)

WELL PURPOSE: home  
(home, irrigation, municipal, industrial)

WELL COMPLETION DATA:

(1) diameter (inches) 4"  
(2) total depth (feet) 160'  
(3) static water level (feet) 30 below top of ground.

CODED

(4) casing 68' (material), (depth)

(size) if telescope see back.

(5) screen (length), (depth to top)

(size), (material)

(6) pump 3/4 hp. 600gpm (HP), (yield gpm)

(type power)

(7) electric log (yes or no)

(organization running log)

(8) how well bottom plugged


DEC 13 1968

MISS. BU. OF WATER CONSERV.

DRILLERS REMARKS:

If well telescopes please sketch and show depths.

GROUND LEVEL

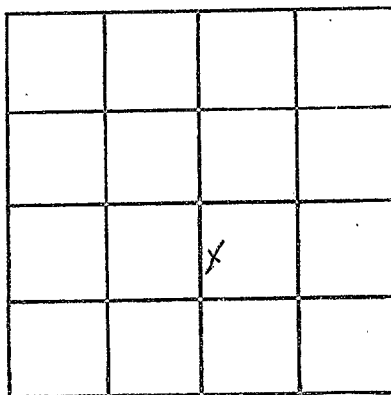

SECTION \_\_\_\_\_

Please indicate well location X.

ADDITIONAL INFORMATION

If more than one screen,  
show locations of each on sketch.