

Lowndes
H 18
8-4-75

MISSISSIPPI
 BOARD OF WATER COMMISSIONERS
 416 North State Street
 Jackson, Mississippi 39201

CODED

WATER WELL DRILLERS LOG

Aug 4 19 75 Clardy well pump Lowndes
 date well completed firm name county well located

LANDOWNER: Stella Sanders

Route 2 Harris Rd.
Columbus, Miss
 (mailing address)

WELL LOCATION:
 sec. 6 T 18 N R 17 E 13L
2 miles NE of Col
 (distance) (direction) (nearest town)

WELL PURPOSE: home
 (home, irrigation, municipal, industrial)

WELL COMPLETION DATA:

- (1) diameter (inches) 4"
- (2) total depth (feet) 180
- (3) static water level (feet) 4 below above-top of ground.
- (4) casing 4" steel, 65
 (material) (depth)
 _____ if telescope see back.
 (size)
- (5) screen _____
 (length) (depth to top)

 (size) (material)
- (6) pump 1/2 hp Sub 12
 (HP) (yield gpm)

 (type power)
- (7) electric log _____
 (yes or no)

 (organization running log)
- (8) how well bottom plugged _____

description of formations encountered	from	to
clay	0	5
sand & gravel	5	20
blue clay	20	35
sandy blue clay	35	60
blue clay	60	85
sandy blue clay	85	95
blue clay	95	115
sandy blue clay	115	140
brown clay	140	155
white clay	155	165
sand	165	180


DRILLERS REMARKS:

RECEIVED
 AUG 11 1975

MISSISSIPPI BOARD OF WATER COMMISSIONERS

If well telescopes please sketch and show depths.

GROUND LEVEL

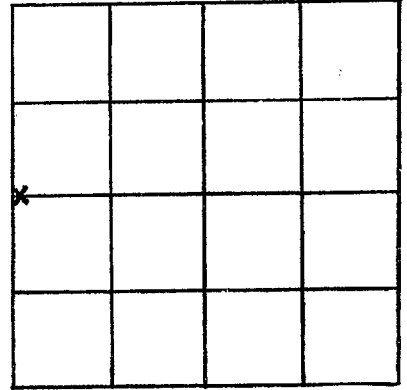

SECTION 6

Please indicate well location X.

ADDITIONAL INFORMATION

If more than one screen,
show locations of each on sketch.