

MISSISSIPPI
BOARD OF WATER COMMISSIONERS
416 North State Street
Jackson, Mississippi 39201

CODED

WATER WELL DRILLERS LOG

Lowndes
H22
5-67

5-23 1967 W. J. REEVES & SON LOWNDES
date well completed firm name county well located

LANDOWNER: B. C. JOHNSON

714 10TH ST. No.

COLUMBUS
(mailing address)

WELL LOCATION: 17
sec. 20 T. 18 S R. 19 E
5 miles E of COLUMBUS
(distance) (direction) (nearest town)

WELL PURPOSE: HOME
(home, irrigation, municipal, industrial)

WELL COMPLETION DATA:


- (1) diameter (inches) 4
- (2) total depth (feet) 110
- (3) static water level (feet) 27 below
top of ground.
- (4) casing STEEL, 4 1/2'
(material) (depth)
4"
(size) if telescope see back.
- (5) screen NONE
(length) (depth to top)
(size) (material)
- (6) pump 3/4 9
(HP) (yield gpm)
ELECT
(type power)
- (7) electric log NO
(yes or no)
(organization running log)
- (8) how well bottom plugged OPEN

description of formations encountered

from to

CLAY	0	14
RED SAND	14	22
BLUE CLAY	22	49
" SAND	49	64
" CLAY	64	66
" CLAY & SAND	66	90
" CLAY	90	110


CODED

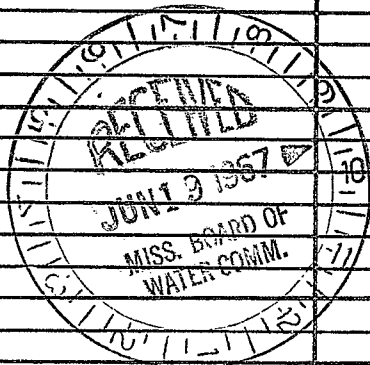

DRILLERS REMARKS:

If well telescopes please sketch and show depths.

GROUND LEVEL

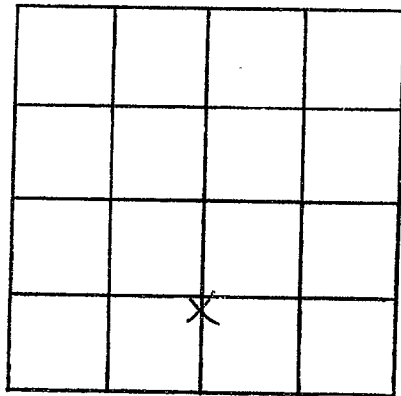

SECTION _____

Please indicate well location X.

ADDITIONAL INFORMATION

If more than one screen, show locations of each on sketch.