

LOWNDES

MISSISSIPPI BOARD OF WATER COMMISSIONERS

QH25  
5-63

WATER WELL DRILLERS LOG

CODED

Date: May, 1963, Driller: W. B. Clardy County Lowe

11160, 61, 62 16507

(Name)

(1) Owner of Land: <sup>ALLEN</sup> Mr. Peirce  
(Name)

718 Lumburg Rd  
(Address)

(2) Location: NE N W N W  
1/4, 1/4, Sec. 18 T18S R17W

3 miles E of Cole.  
(distance) (direction) (Nearest Town)

(3) Topography: Level  
(Hilly) (Flat) (Level)

(4) Purpose of Well: Domestic  
(Domestic Irrigation  
Municipal, Industrial, Other)

Description & Color of Materials Sand, Clay, Red Clay, Shell, etc.	Thick- ness Feet	Depth Feet
<u>Gravel + Sand</u>	<u>8'-20'</u>	
<u>Blue rock</u>	<u>20'-150'</u>	
<u>Sand</u>	<u>150'-170'</u>	

CODED

Information upon completion of well:

(1) Diameter 4 inches.

(2) Total Depth 170 feet.

(3) Water Level \_\_\_\_\_ feet below top of ground.

(4) Cased to 42', Size 4"

(5) Screen: Size \_\_\_\_\_, Length \_\_\_\_\_.

(6) Were any formations sealed against pollution?  
\_\_\_\_\_ yes, \_\_\_\_\_ no.


If YES depth of formation \_\_\_\_\_

Why \_\_\_\_\_

Drillers Remarks: \_\_\_\_\_

\_\_\_\_\_

\_\_\_\_\_

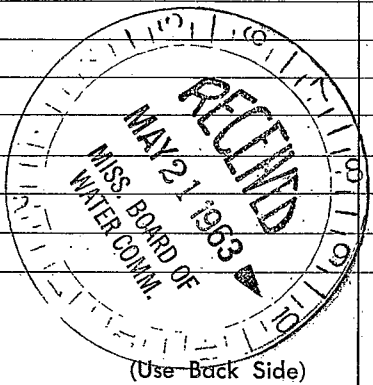

(Use Back Side)

Well No.

