

LOWNOES

MISSISSIPPI BOARD OF WATER COMMISSIONERS

H 27

3-26-63

WATER WELL DRILLERS LOG

CODED

Date: 3/26, 1963, Driller: W.B. Clardy, County: Lauderdale

ELLIS TRAC. CO.

Colonial Collins

(Name)

(1) Owner of Land: Mike Ellis (Name)

Jubilee Rd 3337310 (Address)

(2) Location: NE NW 1/4, Sec. 9 T85 R17W, 4 miles NE of Cal. (distance), (direction), (Nearest Town)

(3) Topography: Hilly (Hilly), (Flat), (Level)

(4) Purpose of Well: Domestic (Domestic Irrigation, Municipal, Industrial, Other)

Description & Color of Materials Sand, Clay, Red Clay, Shell, etc.	Thick- ness Feet	Depth Feet
Sand + Gravel	15'	to 45'
Blue clay	45'	to 50'
Sand	50'	to 75'
Blue clay	75'	to 95'
Sand	95'	to 98'
Blue clay	98'	to 105'
Sand	105'	to 120'

CODED

Information upon completion of well:

(1) Diameter 4 inches.

(2) Total Depth 120 feet.

(3) Water Level 24 feet below top of ground.

(4) Cased to 79', Size 4"

(5) Screen: Size, Length


(6) Were any formations sealed against pollution?

yes, no.

If YES depth of formation

Why

Drillers Remarks:

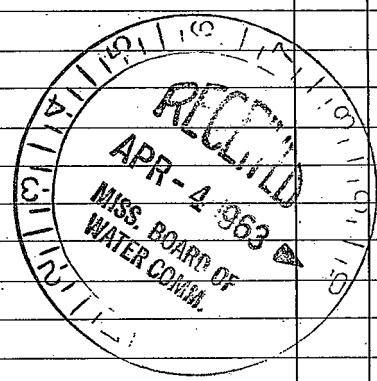

(Use Back Side)

Well No.

