

LOWNDES

H31

6-13-72

MISSISSIPPI BOARD OF WATER COMMISSIONERS 416 North State Street Jackson, Mississippi 39201

WATER WELL DRILLERS LOG

CODED

6/13/72

19

Clardy Well Pump Service

Lounes

date well completed

firm name

county well located

LANDOWNER: Bobby Clardy

904 Ruffin Road

Columbus, Miss

(mailing address)

WELL LOCATION:

sec. 10 T. 18 N. R. 17 west E. 18 W. S.

6 mi miles E of Columbus (distance) (direction) (nearest town)

WELL PURPOSE:

home (home, irrigation, municipal, industrial)

WELL COMPLETION DATA:

- (1) diameter (inches) 4"
(2) total depth (feet) 210
(3) static water level (feet) 41 below above top of ground.
(4) casing Steel Casing, 1 1/2" (material), 111 (depth), 4" if telescope see back. (size)
(5) screen 0 (length), (depth to top) (size) (material)
(6) pump 1/2 Sub 12 gal (HP) (yield gpm) Elec. (type power)
(7) electric log no. (yes or no) (organization running log)
(8) how well bottom plugged

description of formations encountered

from

to

Table with 3 columns: description of formations encountered, from, to. Rows include: red clay (0-8), sand + gravel (8-15), clay + gravel (15-32), blue clay (32-40), streaks of fine sand + clay (40-65), blue clay (65-72), fine sand + clay (72-94), blue clay (94-96), fine sand + clay (96-108), blue clay (108-115), streaks sand + clay (115-130), blue clay (130-138), streaks sand + clay (138-142), blue clay (142-145), soft sandy clay (145-150), brown clay (150-160), grey clay (160-170), rocks (170-171), blue clay (171-180), fine sand (180-190), course sand (190-210)

CODED


JUN 20 1972

MISSISSIPPI WATER CODE

DRILLERS REMARKS:

If well telescopes please sketch and show depths.

GROUND LEVEL

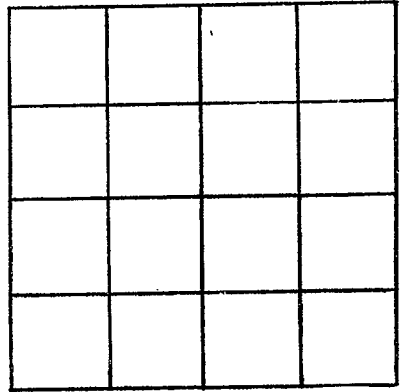

SECTION _____

Please indicate well location X.

ADDITIONAL INFORMATION

If more than one screen,
show locations of each on sketch.