

Lowndes
 H 38
 02/80
 Flor 80

MISSISSIPPI
 BOARD OF WATER COMMISSIONERS
 416 North State Street
 Jackson, Mississippi 39201

CODED

WATER WELL DRILLERS LOG

February 19 80 Herndon Well & Supply, Inc. Lowndes
 date well completed firm name county well located

LANDOWNER: East Lowndes Water Well #2 Association, Inc. P. O. Box. 2072, Columbus, MS 39701 (mailing address)	description of formations encountered	from	to
WELL LOCATION: sec 33 T 18 S R 17 E W 5 miles S E of Columbus (distance) (direction) (nearest town)	Surface Casing	0	12
WELL PURPOSE: Municipal (home, irrigation, municipal, industrial)	Blue Gumbo	12	30
WELL COMPLETION DATA:	Streaked Gumbo & Sand	30	60
(1) diameter (inches) 16" x 10"	Blue Gumbo	60	120
(2) total depth (feet) 510'	Streaked Gumbo & Sand	120	150
(3) static water level (feet) 106 below top of ground.	Blue Gumbo	150	180
(4) casing Steel (material), 440' (depth), 16" (size) if telescope see back.	Streaked Gumbo & Sand	180	240
(5) screen 70' (length), 440' (depth to top), 10" (size) Bar-Weld (material)	Sand	240	270
(6) pump 100 (HP), 1001 (yield gpm)	Sand & Gumbo	270	300
Electric (type power)	Gumbo	300	360
(7) electric log yes (yes or no)	Sand & Gumbo	360	390
U.S. Geological Survey? (organization running log)	Gumbo	390	420
(8) how well bottom plugged 6" BWV	Streaked Sand & Gumbo	420	450
DRILLERS REMARKS:	Sand & Gravel	450	470
	Sand	470	500
	Sand & Gumbo	500	530
	Streaked Gumbo & Sand	530	570
	Streaked Gumbo & Sandy Pink Gumbo	570	600
	Sand & Pink Gumbo	600	630
	Pink Gumbo	630	660
	Blue & Pink Gumbo	660	690
	Gumbo	690	720
	Streaked Gumbo & Sand	620	780
	Sand	780	870
	Pea Gravel & Sand	870	900
	Sand	900	920
	Gumbo	920	930

CODED

DEPT OF NATURAL RESOURCES
 BUREAU OF LAND & WATER RESOURCES


FEB 21 1980

RECEIVED

(X)

If well telescopes please sketch and show depths.

GROUND LEVEL

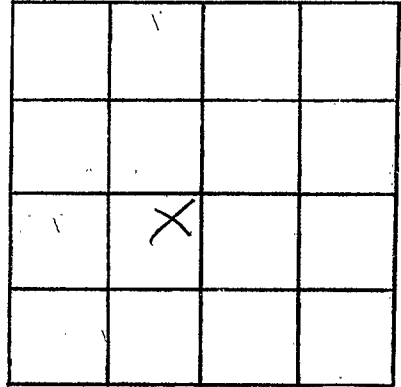

SECTION 33

Please indicate well location X.

ADDITIONAL INFORMATION

If more than one screen, show locations of each on sketch.