	State Well Report	For Office Use Only:		
County: On males	Part 1 – Driller's Log	For Office Ose Only.		
	Mississippi Department of Environmental Quality	Aquifer:		
Permit #:	Office of Land and Water Resources	Well #:		
Driller: Clandy Orull	P.O. Box 10631			
	Jackson, MS 39289-0631	L. S. Elevation: H58		
Date drilling completed: 31807	(601)961-5210	F1#		
	(601)354-6938 (fax)	E-log #:		
State Law requires that this report be prepared by the license holder responsible for the work and filed with the Department at the above address within 30 days of completion of drilling of the well or borehole.				
Information on Well O		orehole Location		
(Landowner if borehole is not fo	r a water well)			
Owner Name Charlie Co	Latitude: 55 ° 51 7 d	" Longitude: 85° 19 '37"		
Owner Name Charles Charles	Method of Lat/Long (circle or	ne): Conventional Survey.		
Mailing Address:	stracle Rd.	,,,,,,,,,,,,,,,,,,,,,,,,,,,,,,,,,,,,,,,		
	USGS quad, Hand-held	GPS, Survey-grade GPS		
	005 D 1/4 W 1/4 Sec 9	Twn 135 Rng 17W		
Columbus	DMS 39702 NW NW	IWI TO KIIG I TU		
City State	e Zip Code Distance Direction	of Columbia		
112 300	a'll Miles West	of Columbus		
Telephone No. (1662) 387 -	3143			
	Well / Borehole Data			
Date drilling started: 51707 Date dri	lling completed: 5/18/07 Hole depth: 147	Hole diameter:		
Location of the source of any surface water	r used for drilling: used in drilling and development: Ala	2004600		
	0	1		
Logs run (circle all applicable): No log run Electric Gamma Ray Density Sonic Neutron Other: Name of organization running log(s):				
Purpose of borehole (check one): Water Well Geotechnical/Geological Investigation Ground Source Heat Pump				
Seismic S	urvey Other (describe)			
Seismic Survey Other (describe) If drilling is not related to water well construction, skip the remainder of this block				
/	dustrial Public Supply Irrigation Fish Culture			
If a flowing well, method of flow regulation: Valve Other (describe)				
Static Water Level: 30' feet above of below circle one) land surface Date measured: 5 18 07				
Method of Measurement (circle one) steel tape electric tape air line other:				
Well depth: 147 Well grouted to a dep	oth of <u>3</u> feet Type of grout (circle one): Neat Cem	Bentonite Mix		
Casing length: 100 feet Casing diameter: 4 inches Type of casing: PVC				
Screen length:feet	n diameter:inchesType of screen:	PVC		
Screen slot size: . 0\3 inches	Setting depth: Fromfeet_to	47 feet		

Gravel packed Underreamed (Telescoped)

Other (describe):

Type of completion (circle all applicable):

Top of lap pipe or reduction in casing:

feet. If telescoped or more than one screen, describe on next page


Open hole

Form: OLWR-SWR-1A

Natural Development

The sketch below only required for water wells

Description of formations encountered must be provided for all wells and boreholes, unless specifically exempted by regulations

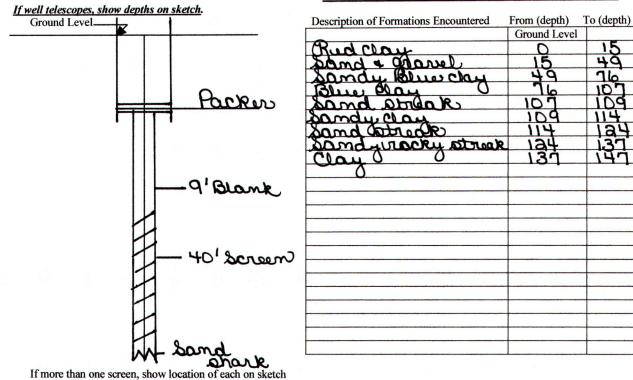

Sketch the property layout and include the following: 1) the well location; 2) any permanent structures on the aid in locating the well; 3) any roads, power lines, or other items that may aid in locating the prediction and a north arrow.	property that may operty and the well;
Barn well	
House	
Dyiva	
Tabernacle Rd	
Landowner Name: Charlie Coggins	

Form: OLWR-SWR-1A

I certify that the well/borehole was drilled, constructed, and completed in accordance with all applicable requirements of the Mississippi Department of Environmental Quality and the Mississippi Department of Health regulations, if applicable, and state

Donald B. Clardy 0-496 5

Print Name of Responsible Licensee and License No.

Date

Signature of Licenses

RECEIVED
JUN 0 1 2007

BY: OLWR

STATE WELL REPORT

Part 2

Pump Installer's Completion Report

Mississippi Department of Environmental Quality Office of Land and Water Resources

For Office Use Only:				
Aquifer:	H58			
Well #:	-GET			
Elevation: _				

Driller: Claracy		Box 10631	FGFI	
Date completed: 5 18 97		IS 39289-0631 961-5210	Well #:	
Copy information from block on Part 1	(601)35		Elevation:	
This part of the report must be completed				
Well Owner Informat		t the above address within 30 days of well completion. Well Location		
Owner Name: Charlie Coggins		Latitude:	Longitude:	
Mailing Address: 771 Labremacle Rd.		Method of Lat/Long (check one): Conventional Survey,		
		USGS quad, Hand-he	ld GPS, Survey-grade GPS	
Columbras City State	5, MS 39702 Zip Code	NW Sec_Distance Direction	9_T185R17W	
			1	
Telephone No. (60) 337 -	3143_	ally Miles West	of Columbia	
Pump Type		Power Type		
Circle one			Circle one	
Air Lift Jet	Submersible	Diesel Engine Gaso	line Engine Natural Gas	
Bucket Piston	Turbine	Electric Motor Hand	i Tractor PTO	
Centrifugal Rotary	Flowing Well	Windmill Other	r (specify):	
Other (specify):		Horse Power Rating of Moto		
Date Pump Installed: 5180	1	Setting Depth: 8	feet	
Rated Pump Capacity: 15	Gallons Per Minute	Number of Stages:	1	
Pump Test Data			feasuring Water Level	
Date Well Tested: 5 18 0			Circle one	
Static Water Level (A): 30 Feet			easuring Line Steel Tape	
Pumping Water Level (B):Feet l	Below Land Surface	Other (specify):	A Section of the Asset of the A	
Drawdown [(B) – (A)]:Feet	Below Land Surface	For flowing well, measured	shut in head:feet	
Test Pumping Rate:	Gallons Per Minute	Well yielded 15	GPM with a drawdown of	
Duration of Pump Test (minimum 4 hours):	hours	feet after	hours of pumping	
I HEREBY CERTIFY that the above statements are true to the best of my knowledge.				
011000-1	0 1101	() DORT	L	

Print Name of Pump Installer and License No. (if applicable)

County: downded

Permit #:

Signature of Pump Installer

FORM: OLWR-SWR-1B JUN 0 1 2007 BY: OLWR