

LOWNDES

MISSISSIPPI BOARD OF WATER COMMISSIONERS

H  
7-15-60

WATER WELL DRILLERS LOG

H300

Date: July 15, 1960, Driller: W. B. Clardy County Lowndes  
(Name)

(1) Owner of Land: C. O. Whitlock  
(Name)  
Hwy. 82 East.  
(Address)

(2) Location: 1/4, 1/4, Sec. T R  
6 miles East, of Columbus  
(distance) (direction) (Nearest Town):

(3) Topography:  (Hilly) (Flat) (Level)

(4) Purpose of Well: Domestic  
(Domestic Irrigation, Municipal, Industrial, Other)

Description & Color of Materials Sand, Clay, Red Clay, Shell, etc.	Thick- ness Feet	Dep- th Feet
<u>Sandy formation and</u>		
<u>light clay down to 40'</u>		
<u>blue clay 40' - 115'</u>		
<u>sand - 115' to 119'</u>		
<u>clay - 119' to 130'</u>		
<u>sand - 130' to 140'</u>		

Information upon completion of well:

(1) Diameter: 4 inches.

(2) Total Depth: 140 feet.

(3) Water Level: 55 feet below top of ground.


(4) Cased to 72, Size 4 in.

(5) Screen: Size \_\_\_\_\_, Length \_\_\_\_\_.

(6) Were any formations sealed against pollution?  
\_\_\_\_\_ yes, \_\_\_\_\_ no.

If YES depth of formation \_\_\_\_\_  
Why \_\_\_\_\_

Drillers Remarks: \_\_\_\_\_  
\_\_\_\_\_  
\_\_\_\_\_

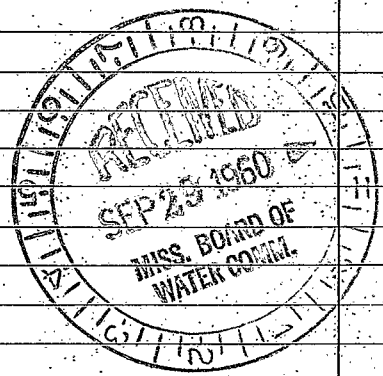

(Use Back Side)

Well No  
H300

