

QH 7003

3-25-63

WATER WELL DRILLERS LOG

Date: 3/25, 1963, Driller: W. B. Clardy County Lounes

(Name)

10891

(1) Owner of Land: James Glover  
(Name)

Description & Color of Materials  
Sand, Clay, Red Clay, Shell, etc.

Thick-  
ness  
Feet

Depth  
Feet

(Address)

(2) Location: 1/4, 1/4, Sec. 9 T/8 R 7W

sand + gravel 15' to 45'  
Blue clay 45'  
sand at 50' to 70'  
Blue clay 70' to 85'  
sand 85' to 100'

4 1/2 miles NE of Colo.  
(distance) (direction) (Nearest Town)

(3) Topography: Level  
(Hilly) (Flat) (Level)

(4) Purpose of Well: Domestic  
(Domestic Irrigation  
Municipal, Industrial, Other)

Information upon completion of well:

(1) Diameter 4 inches.

(2) Total Depth 100 feet.

(3) Water Level 21 feet below top of ground.

(4) Cased to 76' 6" Size 4"

(5) Screen: Size \_\_\_\_\_, Length \_\_\_\_\_


(6) Were any formations sealed against pollution?

\_\_\_\_\_ yes, \_\_\_\_\_ no.

If YES depth of formation \_\_\_\_\_

Why \_\_\_\_\_

Drillers Remarks: \_\_\_\_\_

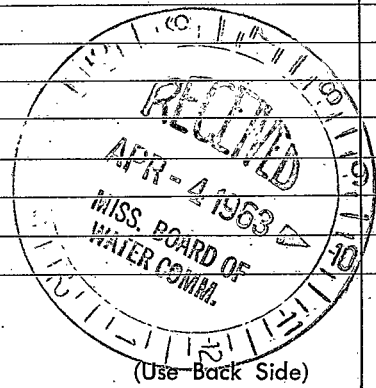

Well No.

