

LOWNDES
H 2004
7-14-77

MISSISSIPPI
 BOARD OF WATER COMMISSIONERS
 416 North State Street
 Jackson, Mississippi 39201

WATER WELL DRILLERS LOG

7-14 ^{13L} 27 Mid South Dwg. Co. Lowndes
 date well completed firm name county well located


LANDOWNER: <u>Don Slincy</u> <u>Lake Lowndes</u> <u>Columbus Ms.</u> (mailing address)	description of formations encountered	from	to
	<u>Yellow clay</u>	<u>0</u>	<u>16</u>
	<u>Blue shale</u>	<u>16</u>	<u>90</u>
	<u>Sand</u>	<u>90</u>	<u>98</u>
	<u>Blue shale and sand</u>	<u>98</u>	<u>230</u>
	<u>and silt</u>		
WELL LOCATION: sec. <u>33</u> T <u>18</u> N R <u>19</u> E <u>3</u> miles <u>SE</u> <u>Heathope</u> (distance) (direction) (nearest town)			
WELL PURPOSE: <u>HOME</u> (home, irrigation, municipal, industrial)			
WELL COMPLETION DATA:			
(1) diameter (inches) <u>4 in.</u>			
(2) total depth (feet) <u>230 ft</u>			
(3) static water level (feet) <u>80</u> below above top of ground.			
(4) casing <u>PVC</u> <u>62'</u> (material) (depth)			
<u>4</u> if telescope see back. (size)			
(5) screen <u>NONE</u> (length) (depth to top)			
(size) (material)			
(6) pump <u>1/2</u> <u>10</u> (HP) (yield gpm)			
<u>E</u> (type power)			
(7) electric log <u>No</u> (yes or no)			
(organization running log)			
(8) how well bottom plugged <u>open hole</u>			
DRILLERS REMARKS:			

RECEIVED
 SEP 11 1977

MISS. BD. OF WATER COMM

If well telescopes please sketch and show depths.

GROUND LEVEL

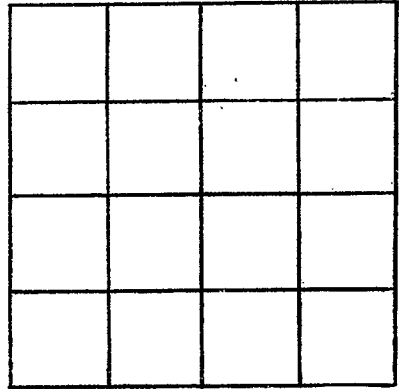

SECTION _____

Please indicate well location X.

ADDITIONAL INFORMATION

If more than one screen, show locations of each on sketch.