

LOWNDES
 H 2000
 9-22-77

MISSISSIPPI
 BOARD OF WATER COMMISSIONERS
 416 North State Street
 Jackson, Mississippi 39201

WATER WELL DRILLERS LOG

9/22 1977 date well completed
 77 Posey Drilling Co. firm name
 LOWNDES county well located

LANDOWNER: Ernest R. Price
 Lehnberg Rd
 Columbus, MS 39701
 (mailing address)

description of formations encountered	from	to
sand + gravel	0	30
blue rock	30	70
streaked sand and blue rock	70	160

WELL LOCATION:
 sec. 7 T. 18 N. R. 17 E.
 1/2 miles S of 82 W of Columbus
 (distance) (direction) (nearest town)

WELL PURPOSE: Home
 (home, irrigation, municipal, industrial)

WELL COMPLETION DATA:

- (1) diameter (inches) 4 1/2
- (2) total depth (feet) 160 ft
- (3) static water level (feet) 20 below top of ground
- (4) casing PVC, 60ft.
 (material) (depth)
 4 1/2 (size) if telescope see back.
- (5) screen AD Screen
 (length) (depth to top)
 (size) (material)
- (6) pump AD Pump
 (HP) (yield gpm)
 (type power)
- (7) electric log (yes or no)

(organization running log)


(8) how well bottom plugged
 DRILLERS REMARKS: AD Screen hole

RECEIVED

SEP 26 1977

If well telescopes please sketch and show depths.

GROUND LEVEL

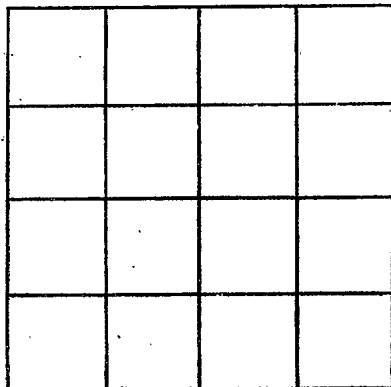

SECTION _____

Please indicate well location X.

ADDITIONAL INFORMATION

If more than one screen,
show locations of each on sketch.