

MISSISSIPPI  
BOARD OF WATER COMMISSIONERS  
416 North State Street  
Jackson, Mississippi 39201

13L

WATER WELL DRILLERS LOG

LOWNDES
H 2007
4-29-77

4-29 1977 date well completed  
Mc South Drilling firm name  
Lawrence county well located

LANDOWNER: Tommy Foster  
Columbus, MS

description of fomations encountered

from to

Br. clay 0 30

Blue clay 30 65

Red clay band  
stratified 65 180

(mailing address)

WELL LOCATION: ?  
sec. 28 T. 18 N. R. 17 E  
S. 6 miles SE of Columbus  
(distance) (direction) (nearest town)

WELL PURPOSE:  
(home, irrigation, municipal, industrial)

WELL COMPLETION DATA:

- (1) diameter (inches) 4"
- (2) total depth (feet) 180'
- (3) static water level (feet) 60 below above top of ground.
- (4) casing PVC, 80,  
(material) (depth)  
         if telescope see back.  
(size)
- (5) screen         ,           
(length) (depth to top)  
        ,           
(size) (material)
- (6) pump         ,           
(HP) (yield gpm)  
          
(type power)
- (7) electric log           
(yes or no)  
          
(organization running log)
- (8) how well bottom plugged


RECEIVED  
JUN 10 1977

DRILLERS REMARKS:

MISS. BOARD OF WATER COMMISSIONERS

If well telescopes please sketch and show depths.

GROUND LEVEL

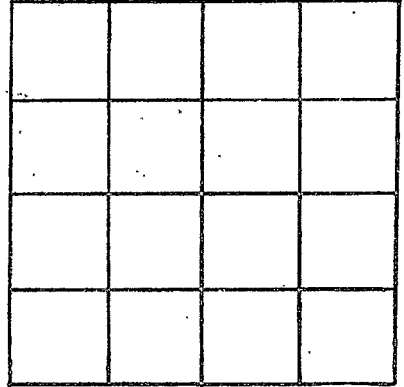

SECTION \_\_\_\_\_

Please indicate well location X.

ADDITIONAL INFORMATION

If more than one screen, show locations of each on sketch.