

LOWNDES

H 2808

6/6/77

MISSISSIPPI BOARD OF WATER COMMISSIONERS
416 North State Street
Jackson, Mississippi 39201

WATER WELL DRILLERS LOG

June 6 1977 ALLSOP Drilling Inc Lowndes
date well completed firm name county well located

LANDOWNER: <u>MR. A.R. GLEW</u> <u>Box 2403</u>	description of formations encountered	from	to
<u>Columbus MS. 39701</u> (mailing address)	<u>Top Soil</u>	<u>0</u>	<u>4'</u>
WELL LOCATION: sec. <u>19</u> T. <u>18</u> N. R. <u>19</u> E. S. <u>3</u> #	<u>gravel & SAND</u>	<u>4</u>	<u>44'</u>
<u>3/4</u> miles <u>EAST</u> of <u>Columbus</u> (distance) (direction) (nearest town)	<u>Muck</u>	<u>44</u>	<u>74</u>
WELL PURPOSE: <u>home</u> (home, irrigation, municipal, industrial)	<u>SAND</u>	<u>74</u>	<u>174</u>
WELL COMPLETION DATA:	<u>Muck</u>	<u>174</u>	<u>205</u>
(1) diameter (inches) <u>4" x 2"</u>	<u>Water SAND</u>	<u>205</u>	<u>300</u>
(2) total depth (feet) <u>300'</u>			
(3) static water level (feet) <u>20</u> below top of ground.			
(4) casing <u>plastic, 120'</u> (material) (depth)			
<u>2"</u> if telescope see back. (size)			
(5) screen <u>30'</u> , <u>220'</u> (length) (depth to top)			
<u>4" x 2"</u> , <u>plastic</u> (size) (material)			
(6) pump <u>1/2</u> , <u>10</u> (HP) (yield gpm)			
<u>Electric</u> (type power)			
(7) electric log <u>WD</u> (yes or no)			
(organization running log)			
(8) how well bottom plugged <u>CAP</u>			
DRILLERS REMARKS:			

RECEIVED
APR 18 1978
MISS. BD. OF WATER COMMISSIONERS


If well telescopes please sketch and show depths.

GROUND LEVEL

110'
4'
C. 2000

110'
2''
C. 2000

100'
C. 2000

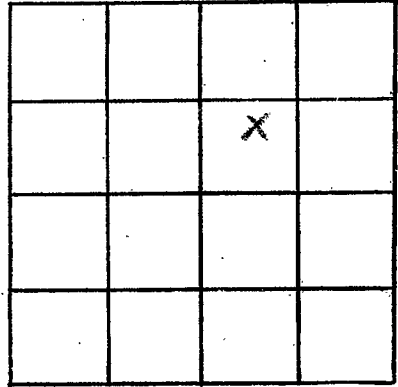

SECTION 19

Please indicate well location X.

ADDITIONAL INFORMATION

If more than one screen, show locations of each on sketch.