

LOWNDES
H 2010
5-15-78

MISSISSIPPI
BOARD OF WATER COMMISSIONERS
416 North State Street
Jackson, Mississippi 39201

WATER WELL DRILLERS LOG

May 15 1978 Mid-South Drilling Co. Lowndes
date well completed firm name county well located

LANDOWNER: Paul St. John
Pt. 4 Box 230
Columbus, Ms. 39701
(mailing address)

WELL LOCATION:
sec. 20 T. 18 S. R. 19 E.
3 miles North of New Hope
(distance) (direction) (nearest town)

WELL PURPOSE: irrigation
(home, irrigation, municipal, industrial)

WELL COMPLETION DATA:
(1) diameter (inches) 4
(2) total depth (feet) 270
(3) static water level (feet) 60 below top of ground.
(4) casing pvc 90 (material) (depth) (size) if telescope see back.
(5) screen none (length) (depth to top) (size) (material)
(6) pump 3/4 9 (HP) (yield gpm) electric (type power)
(7) electric log no (yes or no) none (organization running log)
(8) how well bottom plugged open

description of formations encountered	from	to
Clay	0	97
sand	97	100
Clay	100	112
sand	112	117
Clay	117	130
sand	130	135
Clay	135	160
sand	160	165
sand & clay streaks	165	180
sand	180	190
Clay	190	195
sand	195	200
Clay	200	205
sand	205	223
Clay	223	235
sand	235	250
Clay	250	255
sand	255	259
Clay	259	262
sand	262	266
Clay	266	269
sand	269	270


RESERVED
AUG 10 1978

DRILLERS REMARKS:

MISS. Bd. OF WATER

If well telescopes please sketch and show depths.

GROUND LEVEL

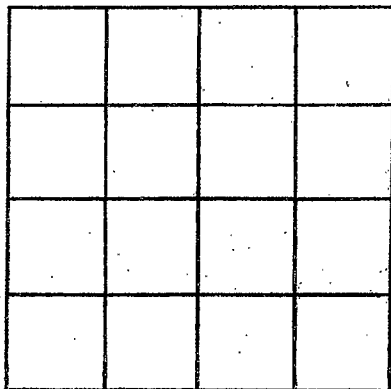

SECTION _____

Please indicate well location X.

ADDITIONAL INFORMATION

If more than one screen, show locations of each on sketch.