

LOWDES
H 2012
8-7-78

**MISSISSIPPI  
BOARD OF WATER COMMISSIONERS**  
416 North State Street  
Jackson, Mississippi 39201

**WATER WELL DRILLERS LOG**

August 7, 1978 Mid-South Drlg. Co. Lowndes  
 date well completed firm name county well located


LANDOWNER: <u>Billy J. Colvin</u>	description of fomations encountered	from	to
<u>Rt. 4 BOX 990</u>			
<u>Columbus, Ms 39701</u> (mailing address)	<u>Clay</u>	<u>0</u>	<u>12</u>
<b>WELL LOCATION:</b>	<u>sand &amp; gravel</u>	<u>12</u>	<u>23</u>
sec. <u>19</u> T. <u>18</u> S. R. <u>19</u> E.	<u>clay</u>	<u>23</u>	<u>45</u>
<u>2</u> miles east of <u>Col.</u>	<u>sand &amp; clay</u>	<u>45</u>	<u>72</u>
(distance) (direction) of (nearest town)	<u>sand</u>	<u>72</u>	<u>75</u>
<b>WELL PURPOSE:</b> <u>home</u> (home, irrigation, municipal, industrial)	<u>clay &amp; sand</u>	<u>75</u>	<u>135</u>
<b>WELL COMPLETION DATA:</b>	<u>sand</u>	<u>135</u>	<u>155</u>
(1) diameter (inches) <u>4</u>	<u>clay &amp; sand</u>	<u>155</u>	<u>165</u>
(2) total depth (feet) <u>165</u>			
(3) static water level (feet) <u>20</u> <sup>below</sup> <del>above</del> top of ground.			
(4) casing <u>Pvc</u> <u>128</u> (material) (depth) (size) If telescope see back.			
(5) screen <u>none</u> (length) (depth to top) (size) (material)			
(6) pump <u>1/2</u> <u>5</u> (HP) (yield gpm) <u>electric</u> (type power)			
(7) electric log <u>no</u> (yes or no) (organization running log)			
(8) how well bottom plugged <u>open</u>			
<b>DRILLERS REMARKS:</b>			

**RECEIVED**  
SEP - 1 1978

MISSISSIPPI BOARD OF WATER COMMISSIONERS

If well telescopes please sketch and show depths.

GROUND LEVEL

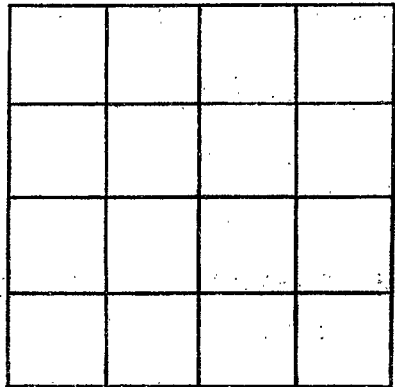

SECTION \_\_\_\_\_

Please indicate well location X.

ADDITIONAL INFORMATION

If more than one screen, show locations of each on sketch.