

LOWMEDES

H 2013

3-2B-79

MISSISSIPPI BOARD OF WATER COMMISSIONERS
416 North State Street
Jackson, Mississippi 39201

WATER WELL DRILLERS LOG

March 15 1979 Mid-South Drilling Lowmes
date well completed firm name county well located

LANDOWNER: <u>Alan Frazer</u>	description of formations encountered	from	to
	Sand & clay	0	15
(mailing address)	Sand	15	30
WELL LOCATION: sec. <u>18</u> T. <u>18</u> S. R. <u>19</u> E. <u>2</u> miles <u>E</u> of <u>Col.</u> (distance) (direction) (nearest town)	Sand + gravel	30	45
	clay	45	75
WELL PURPOSE: <u>Home</u> (home, irrigation, municipal, industrial)	clay & gravel ^{sand}	75	90
WELL COMPLETION DATA:	clay	90	120
(1) diameter (inches) <u>4"</u>	Rock at 95' & 116'		
(2) total depth (feet) <u>160'</u>			
(3) static water level (feet) _____ below top of ground.	clay & sand	120	160
(4) casing <u>PVC</u> <u>75'</u> (material) (depth) <u>4</u> if telescope see back. (size)			
(5) screen <u>NO</u> (length) (depth to top) (size) (material)			
(6) pump <u>1/2</u> <u>10</u> (HP) (yield gpm) <u>electric</u> (type power)			
(7) electric log <u>NO</u> (yes or no) <u>NO</u> (organization running log)			
(8) how well bottom plugged <u>open</u>			
DRILLERS REMARKS:			


Miss. Board of Water Comm.

MAR 27 1979

RECEIVED

If well telescopes please sketch and show depths.

GROUND LEVEL

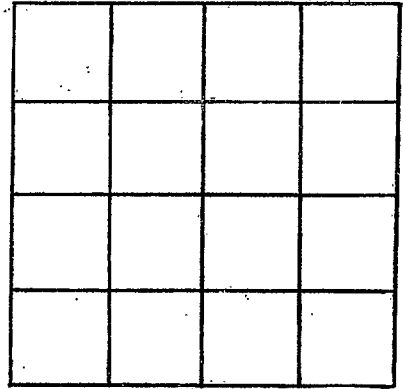

SECTION _____

Please indicate well location X.

ADDITIONAL INFORMATION

If more than one screen,
show locations of each on sketch.