

LOWNDES
H 2014
5-31-79

MISSISSIPPI
 BOARD OF WATER COMMISSIONERS
 416 North State Street
 Jackson, Mississippi 39201

WATER WELL DRILLERS LOG

May 31 1979 Mid-South Drilling Lowndes
 date well completed firm name county well located

LANDOWNER: <u>Howard Bradshaw</u>	description of formations encountered	from	to
<u>PO Box 2143</u> <u>Columbus, MS 39701</u> (mailing address)			
WELL LOCATION: sec. <u>14</u> T <u>18</u> R <u>17</u> <u>84</u> miles <u>E</u> of <u>Col.</u> (distance) (direction) (nearest town)	<u>sand & gravel</u>	<u>0</u>	<u>15</u>
WELL PURPOSE: <u>None</u> (home, irrigation, municipal, industrial)	<u>clay & sand</u>	<u>15</u>	<u>45</u>
WELL COMPLETION DATA: (1) diameter (inches) <u>4"</u>	<u>clay</u>	<u>45</u>	<u>75</u>
(2) total depth (feet) <u>195'</u>	<u>clay & sand</u>	<u>75</u>	<u>135</u>
(3) static water level (feet) <u>40</u> below above top of ground.	<u>clay</u>	<u>135</u>	<u>150</u>
(4) casing <u>PVC</u> , <u>100</u> (material) (depth) <u>4</u> if telescope see back. (size)	<u>clay & sand</u>	<u>150</u>	<u>195</u>
(5) screen <u>None</u> (length) (depth to top) (size) (material)			
(6) pump <u>1/2</u> , <u>10</u> (HP) (yield gpm) <u>electric</u> (type power)			
(7) electric log <u>no</u> (yes or no) <u>no</u> (organization running log)			
(8) how well bottom plugged <u>Open</u>			
DRILLERS REMARKS:			


Miss. Board of Water Comm.

MAY 25 1979

RECEIVED

If well telescopes please sketch and show depths.

GROUND LEVEL

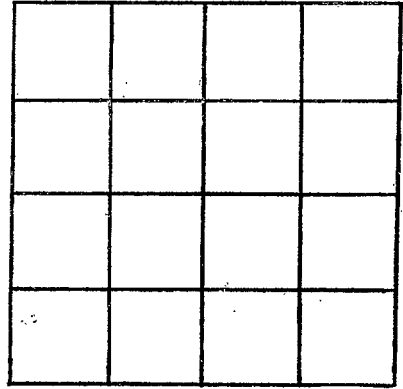

SECTION _____

Please indicate well location X.

ADDITIONAL INFORMATION

If more than one screen, show locations of each on sketch.