

LOWRIDES

MISSISSIPPI DEPARTMENT OF NATURAL RESOURCES
 Bureau of Land and Water Resources
 Southport Mall
 P.O. Box 10631
 Jackson, Mississippi 39209
WATER WELL DRILLERS LOG

H 2016
 6-16-80

6-16-1980 date well completed Clardy Well Drilling firm name Lowndes county well located

LANDOWNER: Clifford Davis Rt 1	description of formations encountered	from	to
Stens, Miss (mailing address)			
WELL LOCATION: sec. 4 T. 18 N R. 17 E 3 miles SW of Stens	Soft sandy clay	43	50
(distance) (direction) (nearest town)	Blue Clay	50	98
	Sand	98'	123'

WELL PURPOSE: Home
 (home, irrigation, municipal, industrial)

- WELL COMPLETION DATA:
- (1) diameter (inches) 4"
 - (2) total depth (feet) 123
 - (3) static water level (feet) 30 below top of ground.
 - (4) casing PVC, 80'
 (material) (depth)
 _____ if telescope see back.
 (size)
 - (5) screen _____
 (length) (depth to top)

 (size) (material)
 - (6) pump 1/2 700 per hr.
 (HP) (yield gpm)
220 elec.
 (type power)
 - (7) electric log no
 (yes or no)

 (organization running log)
 - (8) how well bottom plugged open

DRILLERS REMARKS:


DEPT. OF NATURAL RESOURCES
 BUREAU OF LAND & WATER RESOURCES

JUL -7 1980

RECEIVED

If well telescopes please
sketch and show depths.

GROUND LEVEL

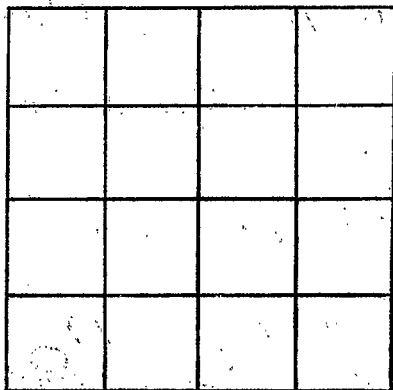

SECTION _____

Please indicate well location X.

ADDITIONAL INFORMATION

If more than one screen,
show locations of each on sketch.