

MISSISSIPPI DEPARTMENT OF NATURAL RESOURCES

Bureau of Land and Water Resources

Southport Mall

P.O. Box 10631

Jackson, Mississippi 39209

WATER WELL DRILLERS LOG

LOWNDES  
H 2018  
9-10-80

9/10 1980 Clardy Well Drilling Lowndes  
 date well completed firm name county well located

LANDOWNER: Ronald Conn  
1217 Ward Rd  
Columbus, Miss.  
 (mailing address)

description of formations encountered	from	to
<u>Sand &amp; gravel</u>	<u>0</u>	<u>30</u>
<u>Soft blue clay</u>	<u>30</u>	<u>70</u>
<u>blue clay</u>	<u>70</u>	<u>118</u>
<u>good sand</u>	<u>118</u>	<u>128</u>
<u>blue clay</u>	<u>128</u>	<u>140</u>

WELL LOCATION:  
 sec. 18 T. 18 N. R. 18 E  
1/2 miles E of Colo.  
 (distance) (direction) (nearest town)

WELL PURPOSE: home  
 (home, irrigation, municipal, industrial)

WELL COMPLETION DATA:

- (1) diameter (inches) 4"
- (2) total depth (feet) 140'
- (3) static water level (feet) 12 below above top of ground.
- (4) casing PVC, 89'  
 (material) (depth)  
 \_\_\_\_\_ if telescope see back.  
 (size)
- (5) screen \_\_\_\_\_  
 (length) (depth to top)  
 \_\_\_\_\_  
 (size) (material)
- (6) pump 1/2 800 gph  
 (HP) (yield gph)  
 \_\_\_\_\_  
 (type power)
- (7) electric log no  
 (yes or no)  
 \_\_\_\_\_  
 (organization running log)
- (8) how well bottom plugged open

DRILLERS REMARKS:


DEPT. OF NATURAL RESOURCES  
 BUREAU OF LAND & WATER RESOURCES

OCT - 8 1980

RECEIVED

If well telescopes please  
sketch and show depths.

GROUND LEVEL

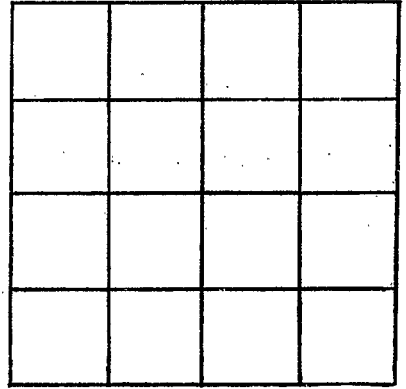

SECTION \_\_\_\_\_

Please indicate well location X.

ADDITIONAL INFORMATION

If more than one screen,  
show locations of each on sketch.