

MISSISSIPPI DEPARTMENT OF NATURAL RESOURCES

Bureau of Land and Water Resources

Southport Mall

P.O. Box 10631

Jackson, Mississippi 39209

WATER WELL DRILLERS LOG

LOWNDES  
H 2020  
12-21-88

12-21 1980 Clardy Well Drilling Lowndes  
 date well completed firm name county well located

LANDOWNER: Dwaine Clark  
Stems Rd  
Columbus, Miss.  
 (mailing address)

WELL LOCATION:  
 sec. 3 T. 18 N. R. 19 E  
4 miles NE of Calh.  
 (distance) (direction) (nearest town)

WELL PURPOSE: Home  
 (home, irrigation, municipal, industrial)

WELL COMPLETION DATA:

- (1) diameter (inches) 4"
- (2) total depth (feet) 155'
- (3) static water level (feet) 33' below above top of ground.
- (4) casing PVC, 105'  
 (material) (depth)  
 (size) if telescope see back.
- (5) screen 1 (length) (depth to top)  
 (size) (material)
- (6) pump 1/3 750 gph  
 (HP) (yield gph)  
Elco.  
 (type power)
- (7) electric log no  
 (yes or no)  
 (organization running log)
- (8) how well bottom plugged \_\_\_\_\_

description of formations encountered	from	to
Sand & gravel	0	12
Sandy fine clay	12	34
fine clay	34	57
streaks of sand & clay	57	88
brown clay	88	96
rock	96	
blue clay	96	138
sand	138	155

DRILLERS REMARKS: \_\_\_\_\_


DEPT. OF NATURAL RESOURCES  
 BUREAU OF LAND & WATER RESOURCES

JAN 9 1981

RECEIVED

If well telescopes please  
sketch and show depths.

GROUND LEVEL

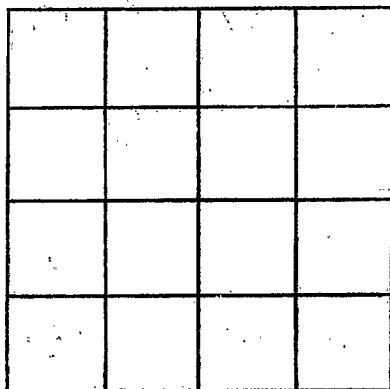

SECTION \_\_\_\_\_

Please indicate well location X.

ADDITIONAL INFORMATION

If more than one screen,  
show locations of each on sketch.