

PH - 328-5221

Lowndes
H 2021
5/21/81

MISSISSIPPI
BOARD OF WATER COMMISSIONERS
416 North State Street
Jackson, Mississippi 39201

3

WATER WELL DRILLERS LOG

5-21-81
date well completed

Martin S. Ralston
firm name

Lowndes
county well located


LANDOWNER: Mc. Fowler
Daedle Drive
Columbus MS 39701
(mailing address)

description of formations encountered	from to	
<u>Red sandy clay</u>	<u>0</u>	<u>14</u>
<u>Sand & gravel</u>	<u>14</u>	<u>24</u>
<u>Blue clay & sand streaks</u>	<u>24</u>	<u>240</u>

WELL LOCATION:
sec. 20 T. 18 N. S. R. 19 E
2 miles E. of Columbus
(distance) (direction) (nearest town)

WELL PURPOSE: VAPOR
(home, irrigation, municipal, industrial)


- WELL COMPLETION DATA:
- (1) diameter (inches) 5"
 - (2) total depth (feet) 240'
 - (3) static water level (feet) 24 below top of ground.
 - (4) casing PVC, 12'
(material) (depth)
(size) if telescope see back.
 - (5) screen _____ (length) _____ (depth to top)
(size) _____ (material)
 - (6) pump _____ (HP) _____ (yield gpm)
(type power)
 - (7) electric log _____ (yes or no)
(organization running log)
 - (8) how well bottom plugged open

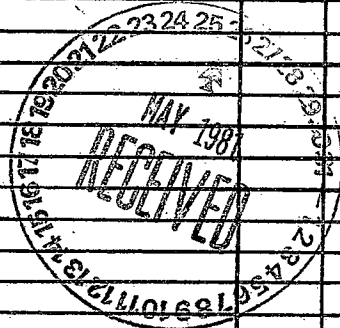

DRILLERS REMARKS:

If well telescopes please sketch and show depths.

GROUND LEVEL

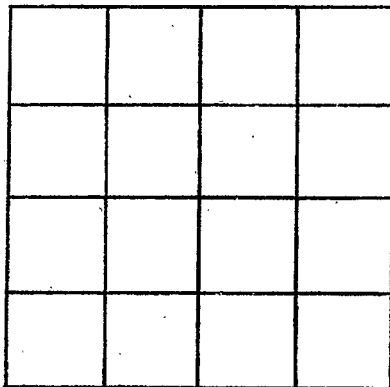

SECTION _____

Please indicate well location X.

ADDITIONAL INFORMATION

If more than one screen, show locations of each on sketch.