

MISSISSIPPI DEPARTMENT OF NATURAL RESOURCES

Bureau of Land and Water Resources

Southport Mall

P.O. Box 10631

Jackson, Mississippi 39209

WATER WELL DRILLERS LOG

Lowndes
H 2023
6-5-81

June 5 1981 date well completed Clardy Well Drilling firm name Lowndes county well located

LANDOWNER: W.B. Clardy
Rt 1 Box 187
Caledonia, Miss.
 (mailing address)

WELL LOCATION:
 sec. 7 T. 18 N. R. 19 E.
1 block miles E. of Caledonia
 (distance) (direction) (nearest town)

WELL PURPOSE: Industrial
 (home, irrigation, municipal, industrial)

WELL COMPLETION DATA:

- (1) diameter (inches) 4"
- (2) total depth (feet) 176 1/2
- (3) static water level (feet) 14' below above top of ground.
- (4) casing PVC, 70'
 (material) (depth)
 (size) if telescope see back.
- (5) screen _____
 (length) (depth to top)
 (size) (material)
- (6) pump 1 1500 gph.
 (HP) (yield gph)
Elec.
 (type power)
- (7) electric log No.
 (yes or no)
 (organization running log)
- (8) how well bottom plugged _____

description of formations encountered	from	to
Gravel	9	34
Clay	34	60
Rocky	60	66
	66	71
Rock	71	
Clay	71	76
Rock	76	
Clay	76	78
Rocky	78	80
Clay	80	84
Sand	84	85
Clay	85	87
Sand	87	87 1/2
Clay	87 1/2	95 1/2
Rock	95 1/2	96 1/2
Clay	96 1/2	102
Rocky	102	104
Clay	104	120 1/2
Sandy streak	120 1/2	121 1/2
Clay	121 1/2	133
Sand	133	133
Clay Sand	133	133
Clay	133	137
Shales streak	137	160
Good sand	160	176 1/2
Rock	176 1/2	

DEPT. OF NATURAL RESOURCES
 BUREAU OF LAND & WATER RESOURCES


JUL - 2 1981

RECEIVED

DRILLERS REMARKS:

If well telescopes please sketch and show depths.

GROUND LEVEL

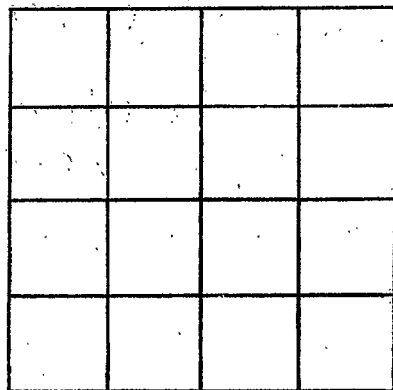

SECTION _____

Please indicate well location X.

ADDITIONAL INFORMATION

If more than one screen,
show locations of each on sketch.