

MISSISSIPPI DEPARTMENT OF NATURAL RESOURCES

Bureau of Land and Water Resources

Southport Mall

P.O. Box 10631

Jackson, Mississippi 39209

WATER WELL DRILLERS LOG

LOWNDES  
H 2025  
8-3-81

8-3 date well completed Steady Well Drilling firm name Lowndes county well located

LANDOWNER: Butch Butler  
Rt 2 Box 195D  
Caledonia, Miss.  
 (mailing address)

WELL LOCATION:  
 sec. 11 T. 18 N. R. 17 W. S. 5  
5 miles (distance) E (direction) of Colo. (nearest town)

WELL PURPOSE: Home  
 (home, irrigation, municipal, industrial)

WELL COMPLETION DATA:

(1) diameter (inches) 4"

(2) total depth (feet) 241'

(3) static water level (feet) 90' below above top of ground.

(4) casing PVC (material) (depth) \_\_\_\_\_  
 \_\_\_\_\_ (size) if telescope see back.

(5) screen Ø Ø (length) (depth to top) \_\_\_\_\_  
 \_\_\_\_\_ (size) (material)

(6) pump 3/4 (HP) 1200 (yield gpm) \_\_\_\_\_  
 \_\_\_\_\_ (type power)

(7) electric log \_\_\_\_\_ (yes or no)  
 \_\_\_\_\_ (organization running log)

(8) how well bottom plugged \_\_\_\_\_

description of formations encountered	depth	
	from	to
Clay	56	70
Sand	70	71
Sandy Strucks	71	80
good solid clay	80	85
rocky sand	85	160
Clay	160	162
Clay	162	187
soft clay	187	192
Clay	192	199
strucks of sand	199	212
Clay	212	215
good solid strucks	215	220
good sand	220	230
Clay	230	232
sand	232	237
Clay	237	241

DEPT. OF NATURAL RESOURCES  
 BUREAU OF LAND & WATER RESOURCES


SEP 15 1981

RECEIVED

DRILLERS REMARKS: \_\_\_\_\_

If well telescopes please sketch and show depths.


GROUND LEVEL

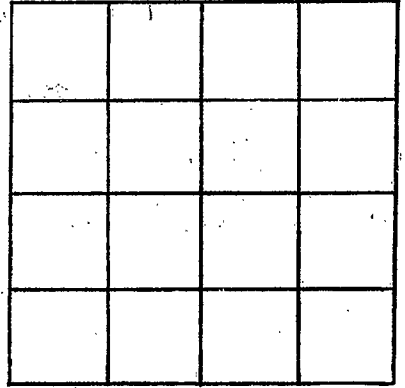

SECTION \_\_\_\_\_

Please indicate well location X.

ADDITIONAL INFORMATION

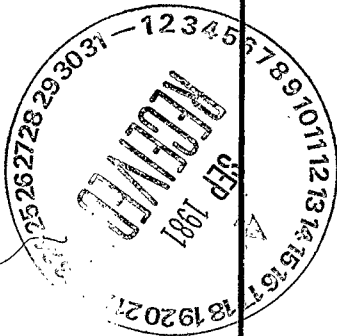

If more than one screen, show locations of each on sketch.