

MISSISSIPPI DEPARTMENT OF NATURAL RESOURCES

Bureau of Land and Water Resources

Southport Mall

P.O. Box 10631

Jackson, Mississippi 39209

WATER WELL DRILLERS LOG

Lowndes
H 2026
7-21-81

7-21 1981 Clardy Well Drilling Lowndes
 date well completed firm name county well located

LANDOWNER: Stephen Burt
Box 2117

Columbus, Ms.
 (mailing address)


WELL LOCATION:
 sec. 16 T-18 N R-19 W
2 1/4 miles E of Cole.
 (distance) (direction) (nearest town)

WELL PURPOSE: Home
 (home, irrigation, municipal, industrial)

WELL COMPLETION DATA:

- (1) diameter (inches) 4"
- (2) total depth (feet) 234'
- (3) static water level (feet) 30' below above top of ground.
- (4) casing PVC 123' of 4"
 (material) (depth)
2" if telescope see back.
 (size)
- (5) screen 43' PVC
 (length) (depth to top)
2" (material)
- (6) pump 1 1/2 3000 gpd.
 (HP) (yield-gpm)
elec. 33 gpm
 (type power)
- (7) electric log no
 (yes or no)
 (organization running log)
- (8) how well bottom plugged


description of formations encountered	depth	
	from	to
<u>Sand & gravel</u>	<u>10</u>	<u>35</u>
<u>Clay</u>	<u>35</u>	<u>57</u>
<u>Sand</u>	<u>57</u>	<u>58</u>
<u>Clay</u>	<u>58</u>	<u>141</u>
<u>Sand</u>	<u>141</u>	<u>153</u>
<u>Clay</u>	<u>153</u>	<u>185</u>
<u>Sand</u>	<u>185</u>	<u>192</u>
<u>Clay</u>	<u>192</u>	<u>196</u>
<u>Sand</u>	<u>196</u>	<u>197</u>
<u>Clay</u>	<u>197</u>	<u>201</u>
<u>Sand</u>	<u>201</u>	<u>234</u>

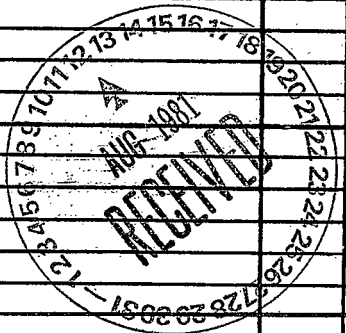

DRILLERS REMARKS:

If well telescopes please sketch and show depths.

GROUND LEVEL

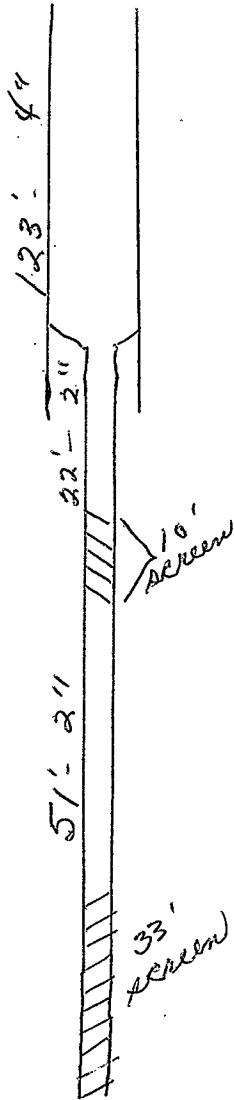

SECTION _____

Please indicate well location X.

ADDITIONAL INFORMATION

If more than one screen, show locations of each on sketch.