

**MISSISSIPPI DEPARTMENT OF NATURAL RESOURCES**  
**Bureau of Land and Water Resources**  
 Southport Mall  
 P.O. Box 10631  
 Jackson, Mississippi 39209  
**WATER WELL DRILLERS LOG**

Lounded  
H  
2028

12-14-81 19 Clardy Well Drilling Lounded  
 date well completed firm name county well located

LANDOWNER: Mike. Kellow  
416 4th. Ave. So -  
Columbus, Miss.  
 (mailing address)

WELL LOCATION:  
 sec. 18 T. 18 N. R. 17 E.  
1/2 miles E of Colo.  
 (distance) (direction) (nearest town)

WELL PURPOSE: Home  
 (home, irrigation, municipal, industrial)

**WELL COMPLETION DATA:**

- (1) diameter (inches) 4"
- (2) total depth (feet) 150
- (3) static water level (feet) 17 below above top of ground.
- (4) casing PVC 68 1/2  
 (material) (depth)  
 \_\_\_\_\_ if telescope see back.  
 (size)
- (5) screen \_\_\_\_\_  
 (length) (depth to top)  
 \_\_\_\_\_  
 (size) (material)
- (6) pump 1/2 950 gph.  
 (HP) (yield gpm)  
elec.  
 (type power)
- (7) electric log no.  
 (yes or no)  
 \_\_\_\_\_  
 (organization running log)
- (8) how well bottom plugged \_\_\_\_\_

description of formations encountered	from	to
<u>sand &amp; gravel</u>	<u>7</u>	<u>30</u>
<u>clay</u>	<u>30</u>	<u>91 1/2</u>
<u>rock</u>	<u>91 1/2</u>	
<u>sand-clay</u>	<u>91 1/2</u>	<u>93 1/2</u>
<u>sand</u>	<u>93 1/2</u>	<u>101</u>
<u>clay</u>	<u>101</u>	<u>103</u>
<u>sand</u>	<u>103</u>	<u>112 1/2</u>
<u>clay</u>	<u>112 1/2</u>	<u>115</u>
<u>rock (2")</u>	<u>115</u>	
<u>clay</u>	<u>115</u>	<u>131</u>
<u>rocks</u>	<u>131</u>	
<u>clay</u>	<u>131</u>	<u>150</u>

DEPT. OF NATURAL RESOURCES  
 BUREAU OF LAND & WATER RESOURCES


JAN 28 1982

**RECEIVED**

DRILLERS REMARKS: \_\_\_\_\_

If well telescopes please sketch and show depths.

GROUND LEVEL

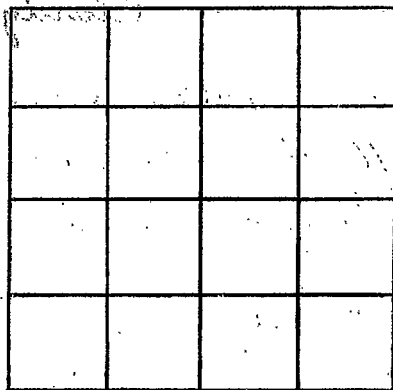

SECTION \_\_\_\_\_

Please indicate well location X.

ADDITIONAL INFORMATION

If more than one screen,  
show locations of each on sketch.