

Lauderdale  
H 2031

MISSISSIPPI  
 BOARD OF WATER COMMISSIONERS  
 416 North State Street  
 Jackson, Mississippi 39201

WATER WELL DRILLERS LOG

5-25 1952 Martin S. H. [unclear] Lauderdale  
 date well completed firm name county well located

LANDOWNER: <u>Ralph R. [unclear]</u>	description of formations encountered	from	to
<u>Columbus, Miss. 39901</u> <u>Crown Rd.</u> (mailing address)			
	<u>hard &amp; gravel</u>	<u>0</u>	<u>32</u>
	<u>blue clay</u>	<u>32</u>	<u>90</u>
	<u>blue clay</u>	<u>90</u>	<u>200</u>

WELL LOCATION:  
 sec 31 T 18 N R 17 E  
3 miles west of NEW HOPE  
 (distance) (direction) (nearest town)

WELL PURPOSE: yard  
 (home, irrigation, municipal, industrial)

- WELL COMPLETION DATA:
- (1) diameter (inches) 4 5/8"
  - (2) total depth (feet) 200'
  - (3) static water level (feet) 12' below above top of ground.
  - (4) casing PVC, 82'  
 (material) (depth)  
 (size) If telescope see back.
  - (5) screen \_\_\_\_\_  
 (length) (depth to top)  
 (size) (material)
  - (6) pump no pump  
 (HP) (yield gpm)  
 (type power)
  - (7) electric log \_\_\_\_\_  
 (yes or no)  
 (organization running log)
  - (8) how well bottom plugged yes


DRILLERS REMARKS:

DEPT. OF NATURAL RESOURCES  
 BUREAU OF LAND & WATER RESOURCES

JUN - 4 1952  
 RECEIVED

If well telescopes please sketch and show depths.

GROUND LEVEL

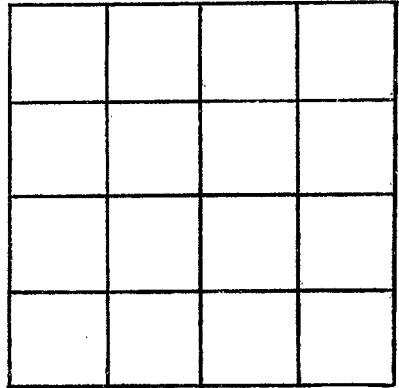

SECTION \_\_\_\_\_

Please indicate well location X.

ADDITIONAL INFORMATION

If more than one screen,  
show locations of each on sketch.