

Lowndes  
H  
2032

MISSISSIPPI  
 BOARD OF WATER COMMISSIONERS  
 416 North State Street  
 Jackson, Mississippi 39201

WATER WELL DRILLERS LOG

5-26 1982 Mark S. Kelly Lowndes  
 date well completed firm name county well located

LANDOWNER: Joe Graft  
Columbus MS, 39701  
 (mailing address)

WELL LOCATION:  
 sec. 5 T. 18 N. R. 19 E.  
1 1/2 miles South of NEW HOPE  
 (distance) (direction) (nearest town)

description of formations encountered	from	to
<u>Sands + gravel</u>	<u>0</u>	<u>28</u>
<u>Blue clay</u>	<u>28</u>	<u>97</u>
<u>Blue clay + sand</u> <u>strata</u>	<u>97</u>	<u>203</u>

WELL PURPOSE: HOME  
 (home, irrigation, municipal, industrial)

- WELL COMPLETION DATA:
- (1) diameter (inches) 4"
  - (2) total depth (feet) 203'
  - (3) static water level (feet) 70 below/above top of ground.
  - (4) casing PVC, 97  
 (material) (depth)  
4" if telescope see back.  
 (size)
  - (5) screen OPEN  
 (length) (depth to top)  
 (size) (material)
  - (6) pump 1/2 10  
 (HP) (yield gpm)  
E  
 (type power)
  - (7) electric log \_\_\_\_\_  
 (yes or no)  
 (organization running log)
  - (8) how well bottom plugged OPEN

DRILLERS REMARKS:


DEPT. OF NATURAL RESOURCES  
 BUREAU OF LAND & WATER RESOURCES

JUN - 4 1982

RECEIVED

If well telescopes please sketch and show depths.

GROUND LEVEL

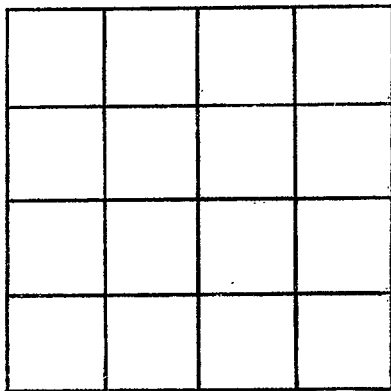

SECTION \_\_\_\_\_

Please indicate well location X.

ADDITIONAL INFORMATION

If more than one screen, show locations of each on sketch.