

MISSISSIPPI DEPARTMENT OF NATURAL RESOURCES

Bureau of Land and Water Resources

Southport Mall

P.O. Box 10631

Jackson, Mississippi 39209

WATER WELL DRILLERS LOG

Louder
H 2035

7/30
date well completed

82 Clardy Well Drilling Louder
firm name

county well located

LANDOWNER: <u>Holliman Coast</u>	description of formations encountered	from	to
<u>Rt. 1</u>	<u>red clay gravel</u>	<u>3</u>	<u>8</u>
<u>Stearns, Miss.</u> (mailing address)	<u>red clay</u>	<u>8</u>	<u>14</u>
	<u>blue clay</u>	<u>14</u>	<u>24</u>
	<u>sandy blue clay</u>	<u>24</u>	<u>45</u>
	<u>blue clay</u>	<u>45</u>	<u>70</u>
	<u>sandy clay</u>	<u>70</u>	<u>79</u>
	<u>rock</u>	<u>79</u>	<u>79 1/2</u>
	<u>sandy clay</u>	<u>79 1/2</u>	<u>81</u>
	<u>blue clay</u>	<u>81</u>	<u>86</u>
	<u>sandy clay</u>	<u>86</u>	<u>85 1/2</u>
	<u>rock 2"</u>	<u>85 1/2</u>	
	<u>sandy clay</u>	<u>85 1/2</u>	<u>88</u>
	<u>blue clay</u>	<u>88</u>	<u>91</u>
	<u>sand</u>	<u>91</u>	<u>95</u>
	<u>rock 3"</u>	<u>95</u>	
	<u>good clay</u>	<u>95</u>	<u>103</u>
	<u>gummy clay</u>	<u>103</u>	<u>116</u>
	<u>blue clay</u>	<u>116</u>	<u>121 1/2</u>
	<u>rock</u>	<u>121 1/2</u>	<u>122</u>
	<u>blue clay</u>	<u>122</u>	<u>124 1/2</u>
	<u>rock 12"</u>	<u>124 1/2</u>	
	<u>sand</u>	<u>124 1/2</u>	<u>129</u>
	<u>blue clay</u>	<u>129</u>	<u>145</u>
	<u>rock</u>	<u>145</u>	<u>145 1/2</u>
	<u>blue clay</u>	<u>145 1/2</u>	<u>151</u>
	<u>sandy clay</u>	<u>151</u>	<u>160</u>
	<u>sand</u>	<u>160</u>	<u>163</u>
	<u>sandy clay</u>	<u>163</u>	<u>168</u>
	<u>sand</u>	<u>168</u>	<u>175</u>
	<u>sandy clay</u>	<u>175</u>	<u>176</u>
	<u>brown clay</u>	<u>176</u>	<u>178</u>
	<u>blue clay</u>	<u>178</u>	<u>203</u>
	<u>rock 2"</u>		
	<u>sandy clay</u>	<u>203</u>	<u>206</u>
	<u>rock 6"</u>		
	<u>sandy clay</u>	<u>206 1/2</u>	<u>209</u>
	<u>sand</u>	<u>209</u>	<u>231 1/2</u>
	<u>rock</u>	<u>231 1/2</u>	

WELL LOCATION:

sec. 10 T. 18 N. R. 19 E.
6 miles SE of Col.
(distance) (direction) (nearest town)

WELL PURPOSE: home
(home, irrigation, municipal, industrial)

WELL COMPLETION DATA:

- (1) diameter (inches) 4"
- (2) total depth (feet) 231 1/2
- (3) static water level (feet) 40' - 10" below above top of ground.
- (4) casing PVC, 100'
(material) (depth)
(size) if telescope see back.
- (5) screen _____ (length) (depth to top)
(size) (material)
- (6) pump 1/2, 800 gph.
(HP) (yield gpm)
- elec.
(type power)
- (7) electric log no
(yes or no)
(organization running log)

(8) how well bottom plugged

DRILLERS REMARKS:


AUG 20 1982

RECEIVED

DEPT. OF NATURAL RESOURCES
BUREAU OF LAND & WATER RESOURCES

If well telescopes please sketch and show depths.

GROUND LEVEL

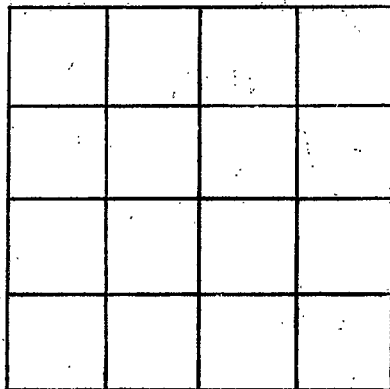

SECTION _____

Please indicate well location X.

ADDITIONAL INFORMATION

If more than one screen, show locations of each on sketch.