

Landowner
H
2037

MISSISSIPPI
 BOARD OF WATER COMMISSIONERS
 416 North State Street
 Jackson, Mississippi 39201

WATER WELL DRILLERS LOG

11-4
 date well completed

1982 Martin S. Kappeler
 firm name

Landowner
 county well located

LANDOWNER: G.R. Mardice
Columbus ms.
90 Mardice's Grassy
 (mailing address)

description of formations encountered	from	to
<u>Sandy clay</u>	<u>0</u>	<u>12</u>
<u>Brown clay</u>	<u>12</u>	<u>32</u>
<u>Blue clay</u>	<u>32</u>	<u>112</u>
<u>rock</u>	<u>112</u>	<u>113</u>
<u>Blue clay + sand streaks</u>	<u>113</u>	<u>180</u>
<u>hard</u>	<u>180</u>	<u>240</u>

WELL LOCATION:
 sec. 23 T. 18 N. R. 19 E.
S W
8 miles E of Columbus
 (distance) (direction) (nearest town)

WELL PURPOSE: TAVERN
 (home, irrigation, municipal, industrial)

- WELL COMPLETION DATA:
- (1) diameter (inches) 4"
 - (2) total depth (feet) 240"
 - (3) static water level (feet) 88' below top of ground.
 - (4) casing PVC 140'
 (material) (depth)
4" if telescope see back.
 (size)
 - (5) screen _____
 (length) (depth to top)
 (size) (material)
 - (6) pump 1/2 10
 (HP) (yield gpm)
E
 (type power)
 - (7) electric log _____
 (yes or no)
 (organization running log)
 - (8) how well bottom plugged open

DEPT. OF NATURAL RESOURCES
 BUREAU OF LAND & WATER RESOURCES


NOV 10 1982

RECEIVED

DRILLERS REMARKS: _____

If well telescopes please sketch and show depths.

GROUND LEVEL

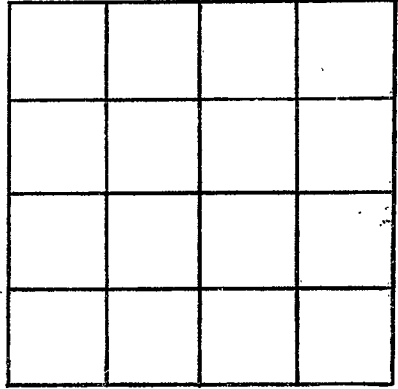

SECTION _____

Please indicate well location X.

ADDITIONAL INFORMATION

If more than one screen, show locations of each on sketch.