

Lowndes  
H  
2039

MISSISSIPPI DEPARTMENT OF NATURAL RESOURCES  
 Bureau of Land and Water Resources  
 Southport Mall  
 P.O. Box 10631  
 Jackson, Mississippi 39209  
**WATER WELL DRILLERS LOG**

9-28 1982 Clardy Well Drilling Lowndes  
 date well completed firm name county well located

LANDOWNER: Floyd Stiles  
P.O. Box 1808  
Columbus, Miss.  
 (mailing address)

WELL LOCATION:  
 sec. 18 T. 18 N R. 17 E  
1/2 miles S of Colo.  
 (distance) (direction) (nearest town)

WELL PURPOSE: Home  
 (home, irrigation, municipal, industrial)

- WELL COMPLETION DATA:
- diameter (inches) 4"
  - total depth (feet) 142'
  - static water level (feet) 16' below above top of ground.
  - casing PVC 82'  
 (material) (depth)  
 (size) If telescope see back.
  - screen \_\_\_\_\_  
 (length) (depth to top)  
 (size) (material)
  - pump 1/2 900 gph.  
 (HP) (yield gph)  
 (type power)
  - electric log No  
 (yes or no)  
 (organization running log)
  - how well bottom plugged \_\_\_\_\_

description of formations encountered	depth	
	from	to
Clay	0	9
sand & gravel	9	29
sandy blue clay	29	36
good blue clay	36	48
sandy clay	48	52
good clay	52	84
rock	84	84 1/2
good clay	84 1/2	88 1/2
rock	88 1/2	89
hard blue clay	89	100
sandy clay	100	105
hard clay	105	121
good sand	121	140
hard clay	140	142

DEPT. OF NATURAL RESOURCES  
 BUREAU OF LAND & WATER RESOURCES


NOV - 1 1982

RECEIVED

DRILLERS REMARKS:

If well telescopes please sketch and show depths.

GROUND LEVEL

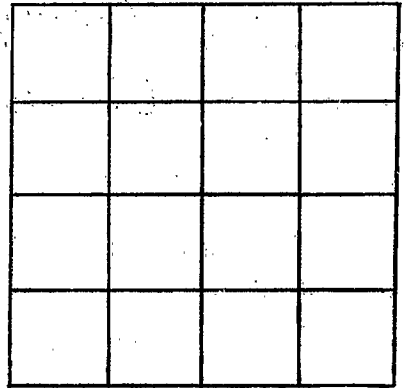

SECTION \_\_\_\_\_

Please indicate well location X.

ADDITIONAL INFORMATION

If more than one screen, show locations of each on sketch.